


T.I.O.S.R.I E.W.M.

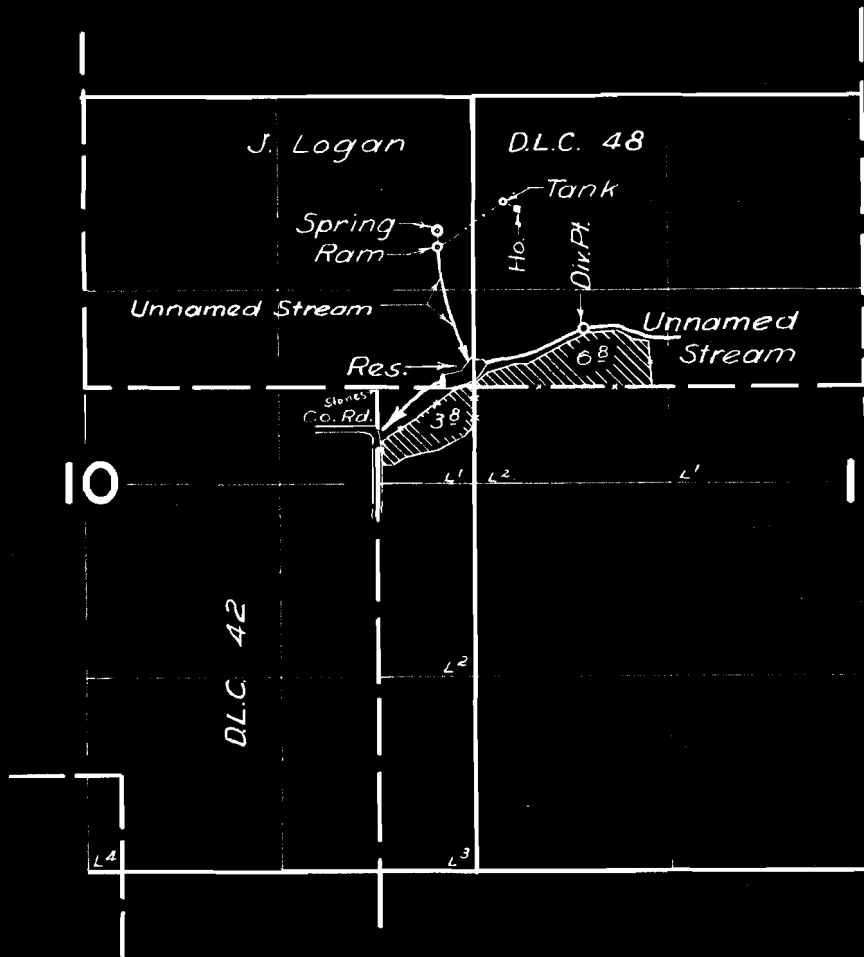

R-26017
26018

R-1219
20557

George M. Krantz

June 3 57 Tm. Bish