


T. 7 S. R. 4 W. W. M.

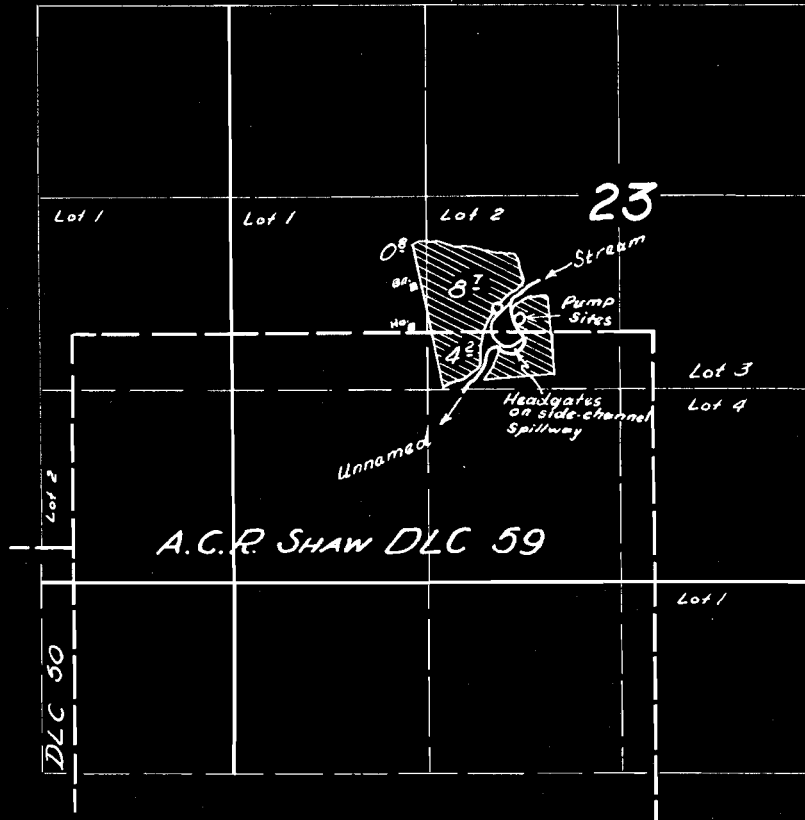

**FINAL PROOF SURVEY**

UNDER

R-26921

R-1337

Application No. 26922 Permit No. 21153

IN NAME OF

T. J. PRIMUS

Surveyed 18 Mar. 1957, by *R. A. Whitley*