


T.7S.R.4W.W.M.

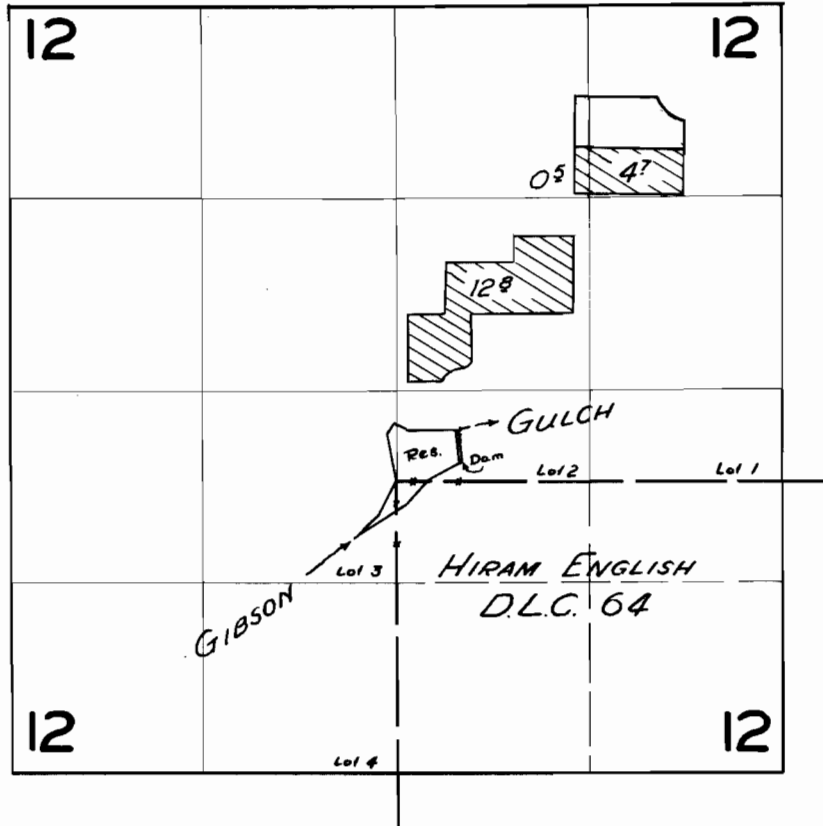

FINAL PROOF SURVEY

UNDER

R-24792

R-1453

Application No. 24793 Permit No. 21911

IN NAME OF

Fred Gibson

Surveyed 15 Mar. 1957, by [Signature]