T. 7 S. R. 4 W.W.M.

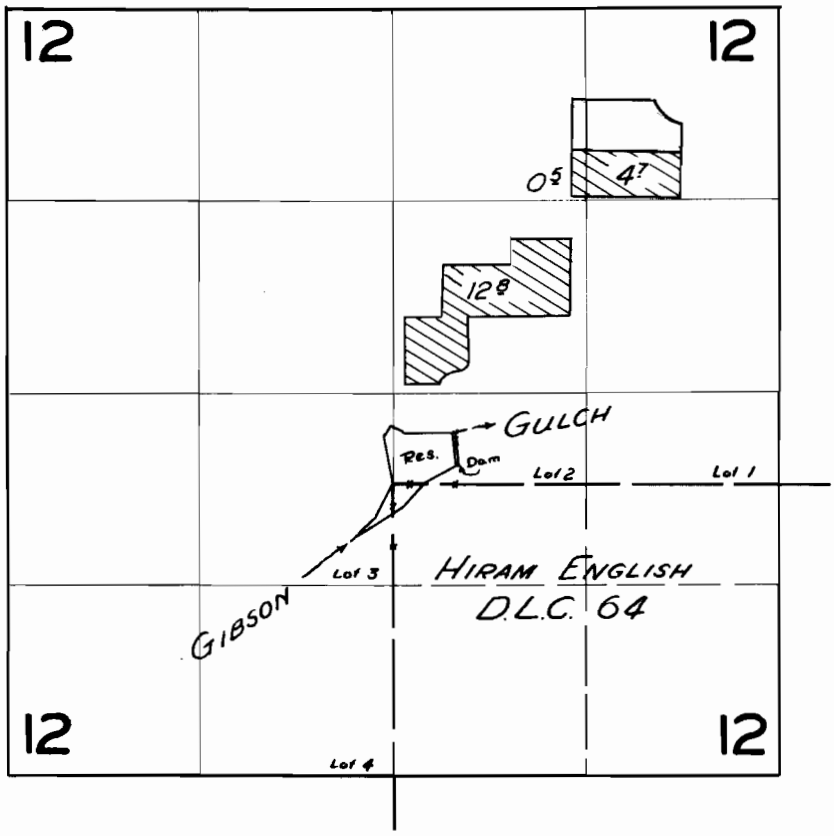

FINAL PROOF SURVEY

UNDER

Application No. R-24792 24793 Permit No. R-1453 21911

IN NAME OF

Fred Gibson

Surveyed 15 Mar 1957, by [signature]

DFP-2D-36
1957-PIC