


# T27SR7WWM

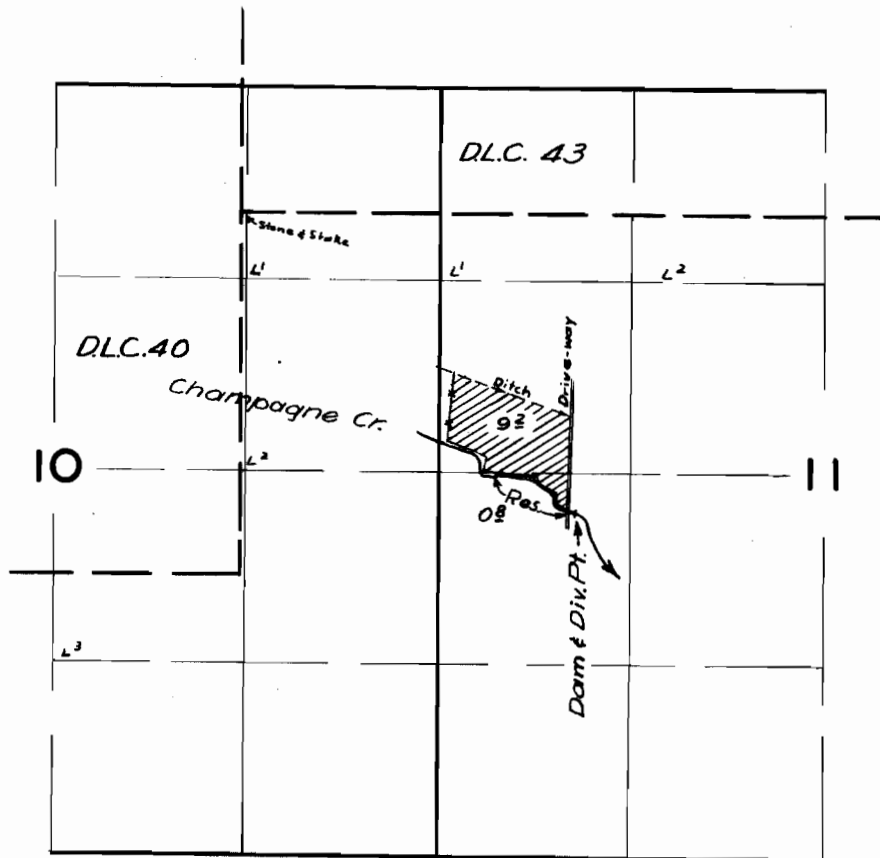

## FINAL PROOF SURVEY

UNDER

R-28056

R-1476

Application No. 28057 Permit No. 22068

IN NAME OF

S. J. Cooper

Surveyed July 19, 1957, by M. B. Bush