


T. 3 S. R. 3 W. W.M.

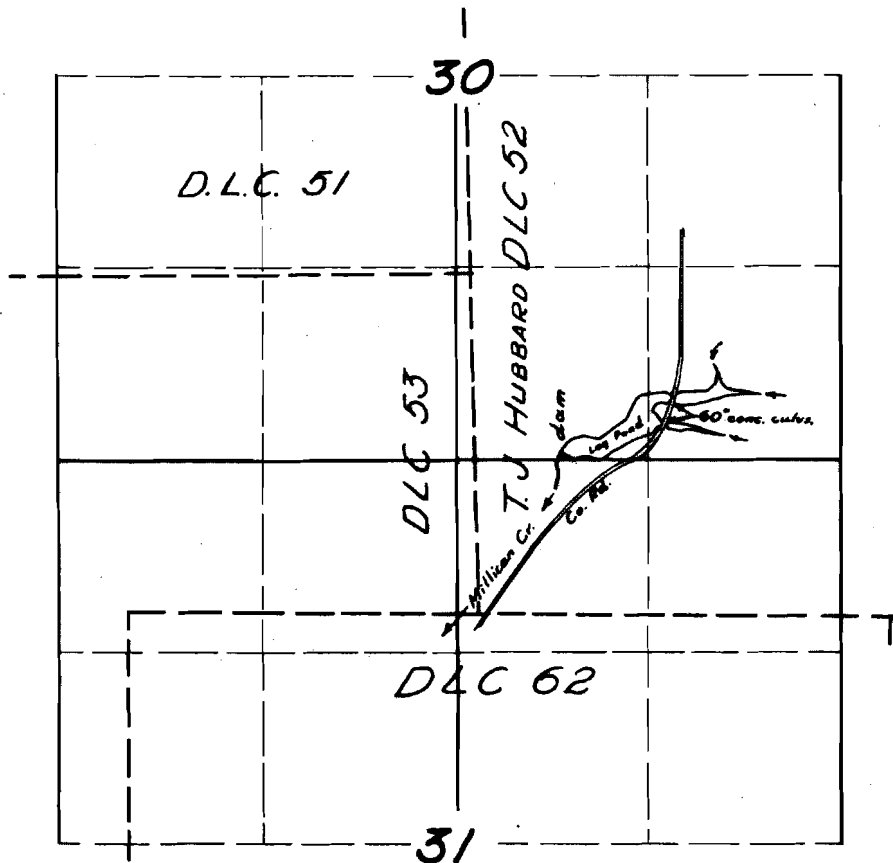

FINAL PROOF SURVEY

UNDER

R-27710

R-1587

Application No. 29038 Permit No. 22802

IN NAME OF

H. R. KUEHNE

Surveyed 6 Apr. 1956, by [Signature]