


T.2 S. R.3 E. W.M.

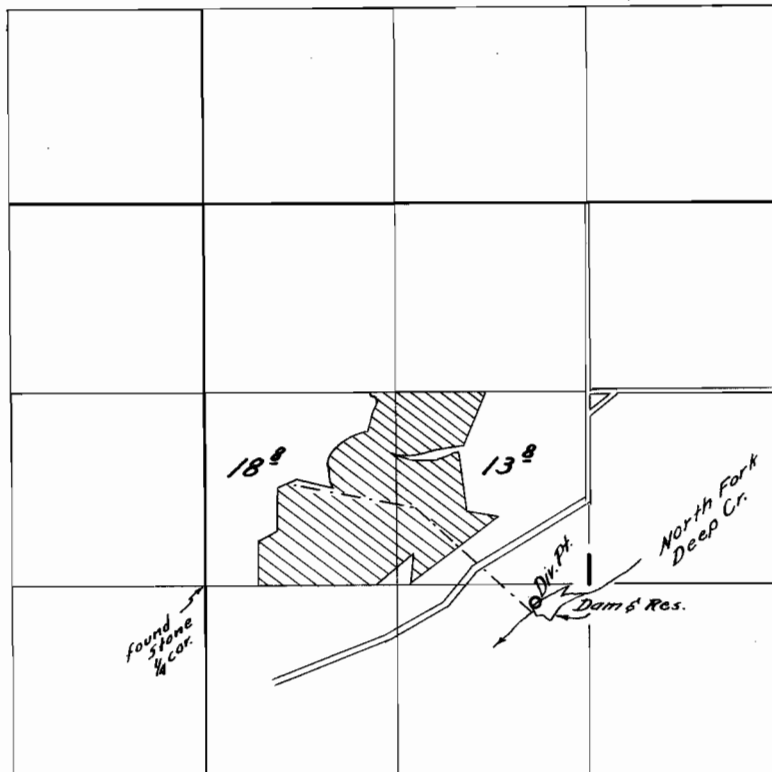

FINAL PROOF SURVEY

UNDER

26596

20833

R-28430

R-1588

Application No. 28431 Permit No. 22737

IN NAME OF

L. E. & J. E. Meier

Surveyed June 23 1956, by *R. H. Whitby*

DFK-5D-17