


T.2 S. R.3 E. W.M.

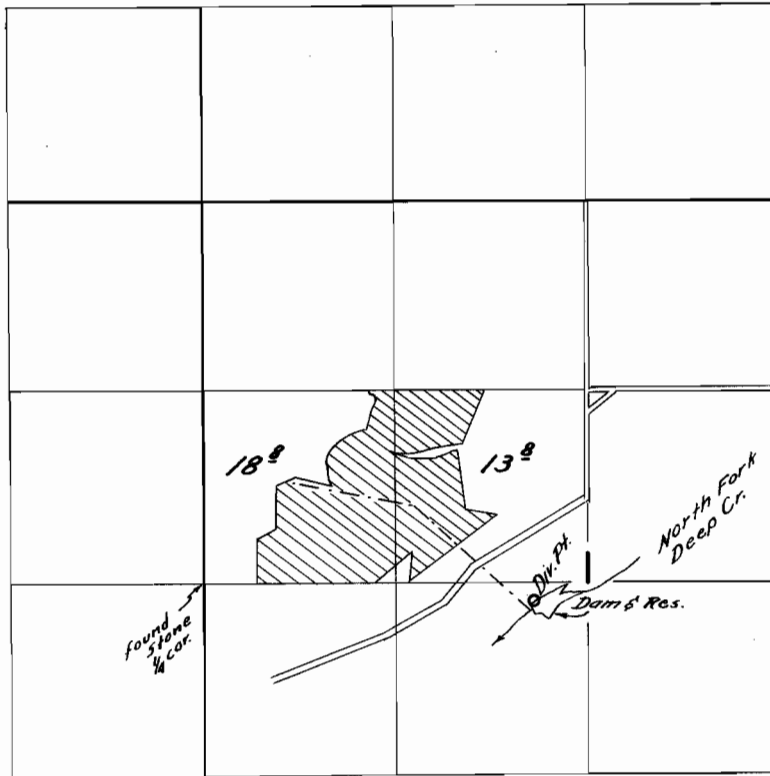

FINAL PROOF SURVEY

UNDER

Application No. ²⁶⁵⁹⁶~~28431~~ ^{R-28430} Permit No. ²⁰⁸³³~~22737~~ ^{R-1588}

IN NAME OF

..... *L. E. & J. F. Meier*

Surveyed *June 23* 1956, by *R. H. Whitby*

DFK-5D-17