


T.2 S. R.3 E. W.M.

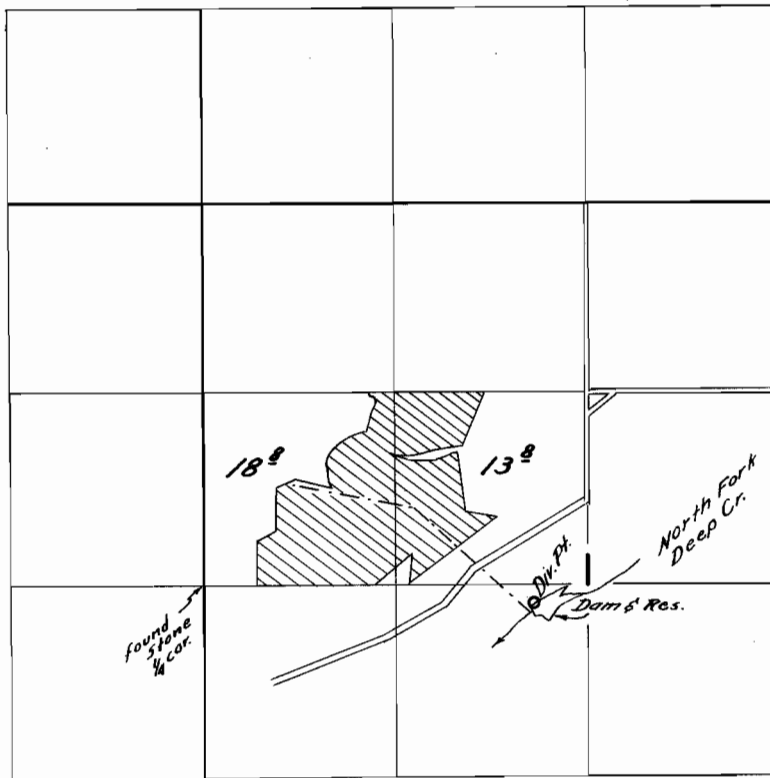

FINAL PROOF SURVEY

UNDER

Application No. ²⁶⁵⁹⁶_{R-28730} ~~28731~~ Permit No. ²⁰⁸³³_{R-1588} ~~22737~~

IN NAME OF

..... *L. E. & J. F. Meier*

Surveyed *June 23* 1956, by *R. H. Whitby*

DFK-5D-17