



T.10S.R.26E.W.M.

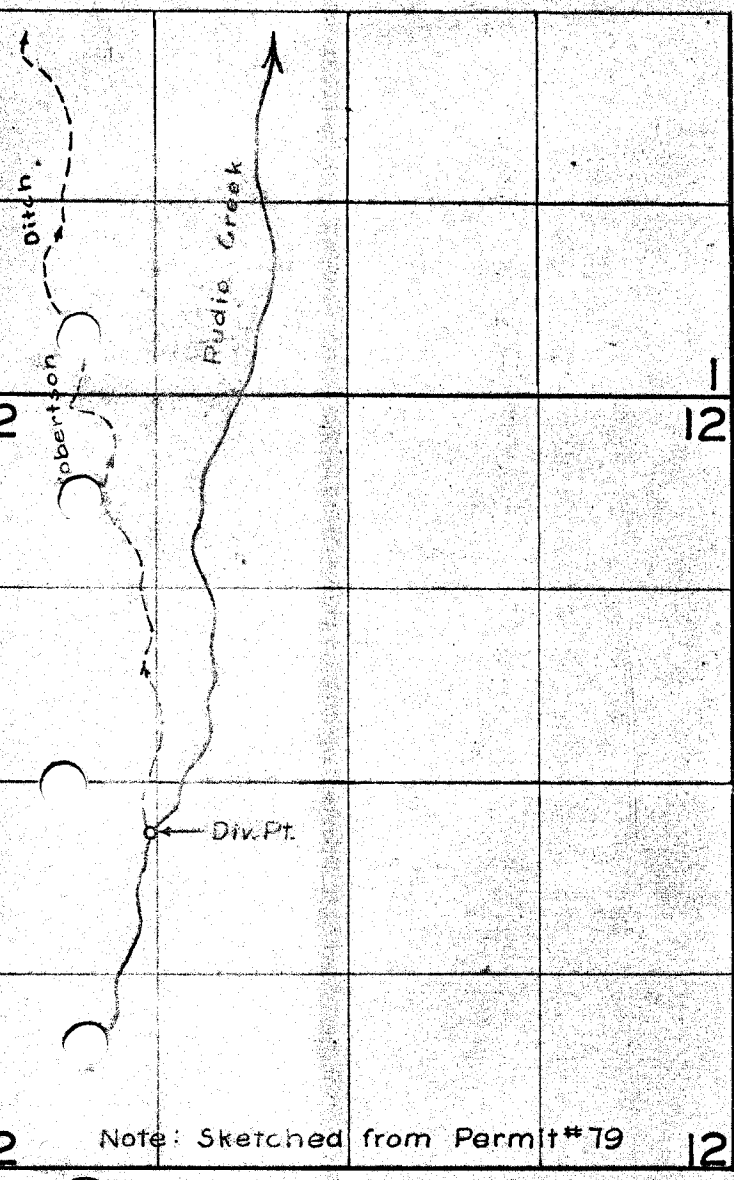

T.9&10S.R.26 E.W.M.

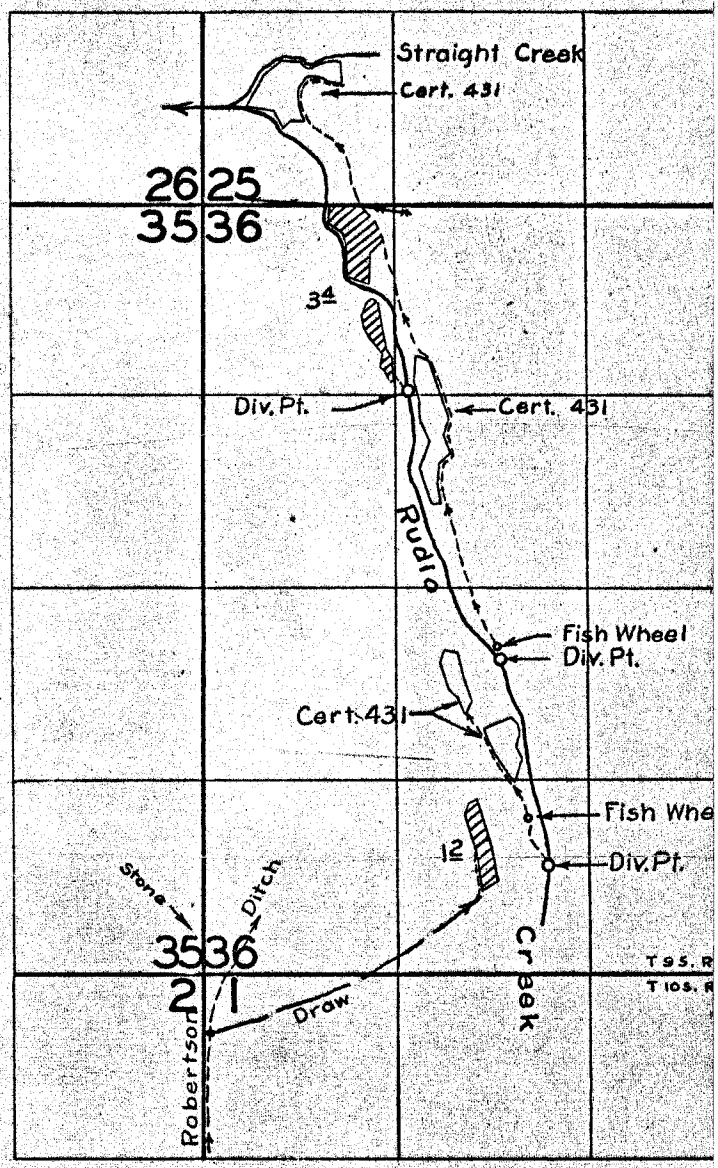

FINAL PROOF SURVEY

UNDER

Application No. 10200 Permit No. 13843

IN NAME OF

G.G. Capon & The Estate of H.H. Capon

Surveyed 24 Sept 1957, by m. Bish