


T.8 & 9 S. R. 27 & 28 E. W.M.

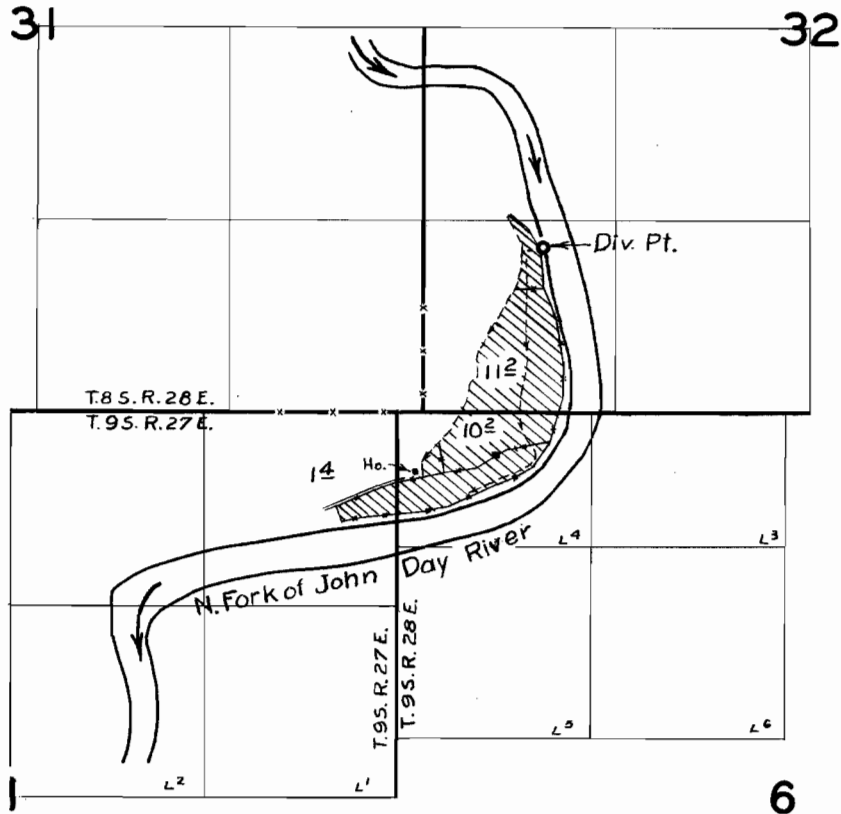

FINAL PROOF SURVEY UNDER

Application No. 18835 Permit No. 14472
IN NAME OF

J. M. Stubblefield

Surveyed 23 Sept. 1957, by *m. G. Sisk*