




T. 13 S.R. 27 E.W.M.

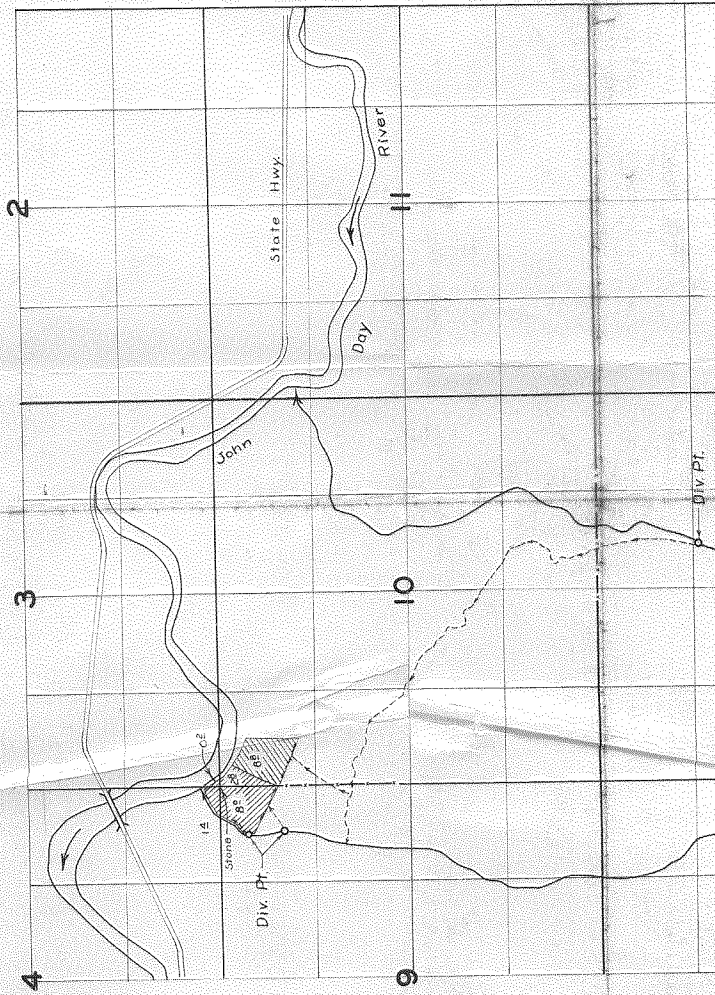

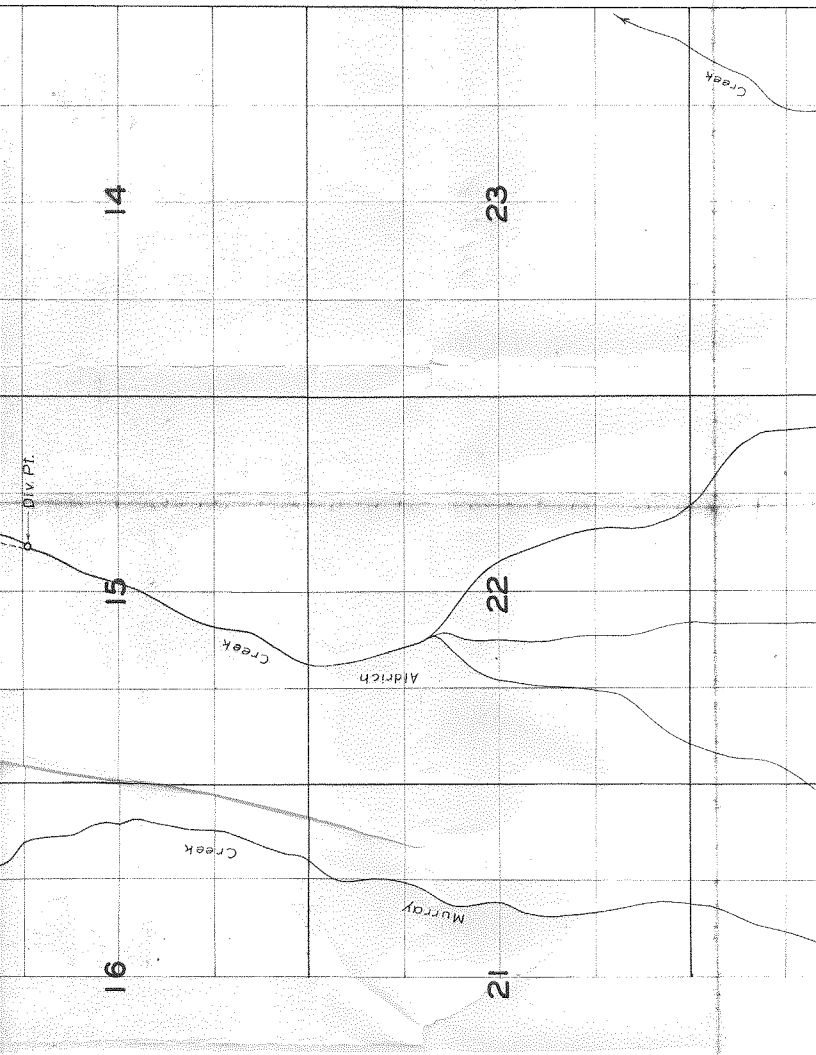

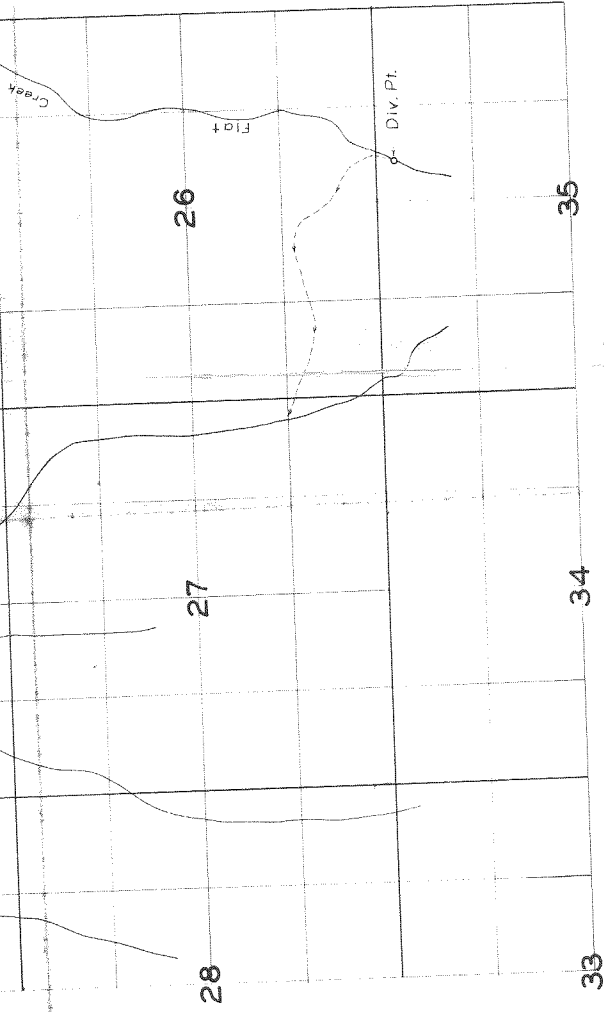

FINAL PROOF SURVEY

Application No. 20810, County No. 16461, ...  
BY NAME OF

George MacKay

Surveyed 20 Sept. 1951, by T. B. ...