


T.3N.R. 2W.W.M.

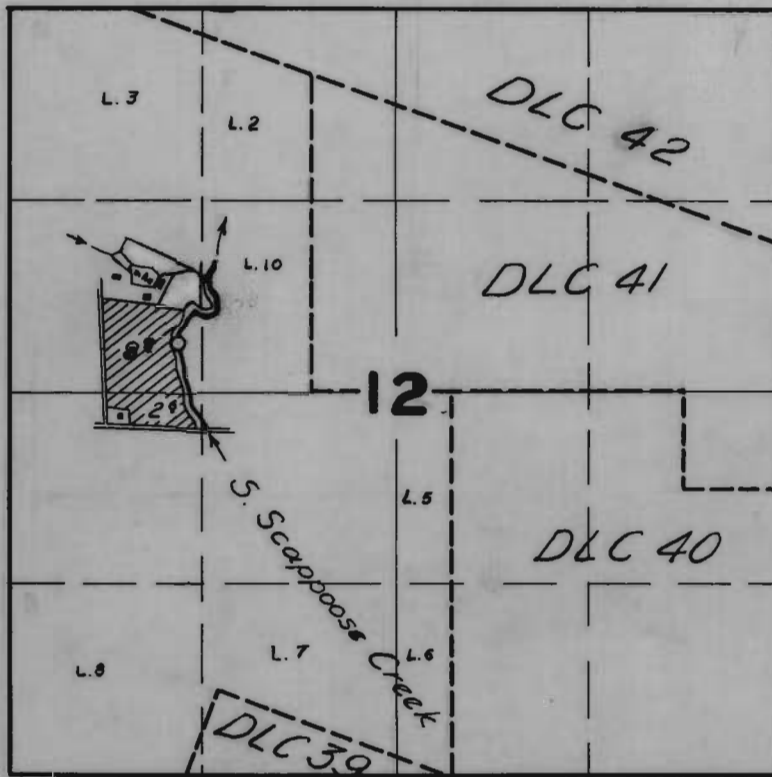

FINAL PROOF SURVEY

UNDER

Application No. 21755 Permit No. 17113

IN NAME OF

*Richard C & Doris M. Luncsford*

Surveyed AUG. 5, 1956, by *H. L. Coffman*