


T. 30S. R. 4W.W.M.

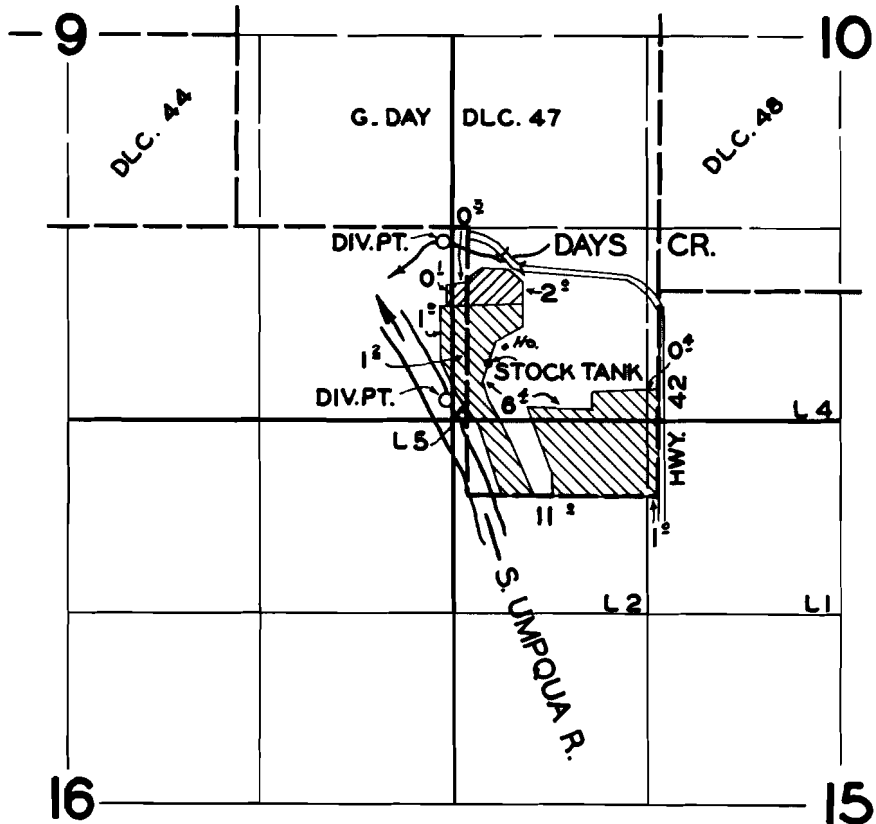

FINAL PROOF SURVEY
UNDER

Application No. 22247 Permit No. 17547
IN NAME OF

ALBERT M. ROWE

Surveyed JULY 27, 1957, by *Tom Bish*