


3-17-79
3-17-80 START CONS A
OCT 1 81 FINISH CONT B
OCT 1 82 ADJUT

T.17 S.R.27 E.W.M.

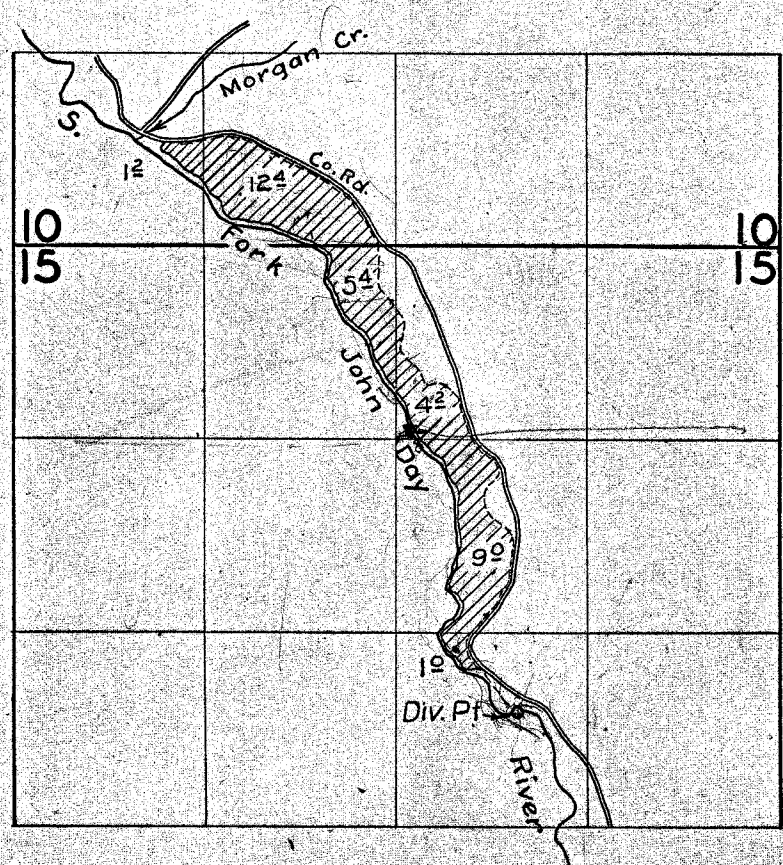

FINAL PROOF SURVEY
UNDER

Application No. 22333... Permit No. 17609...
IN NAME OF

Bonham H. Keerins

Surveyed Sept. 19 1957, by Tom Bish