



T. 16S. R. 24E. W.M.

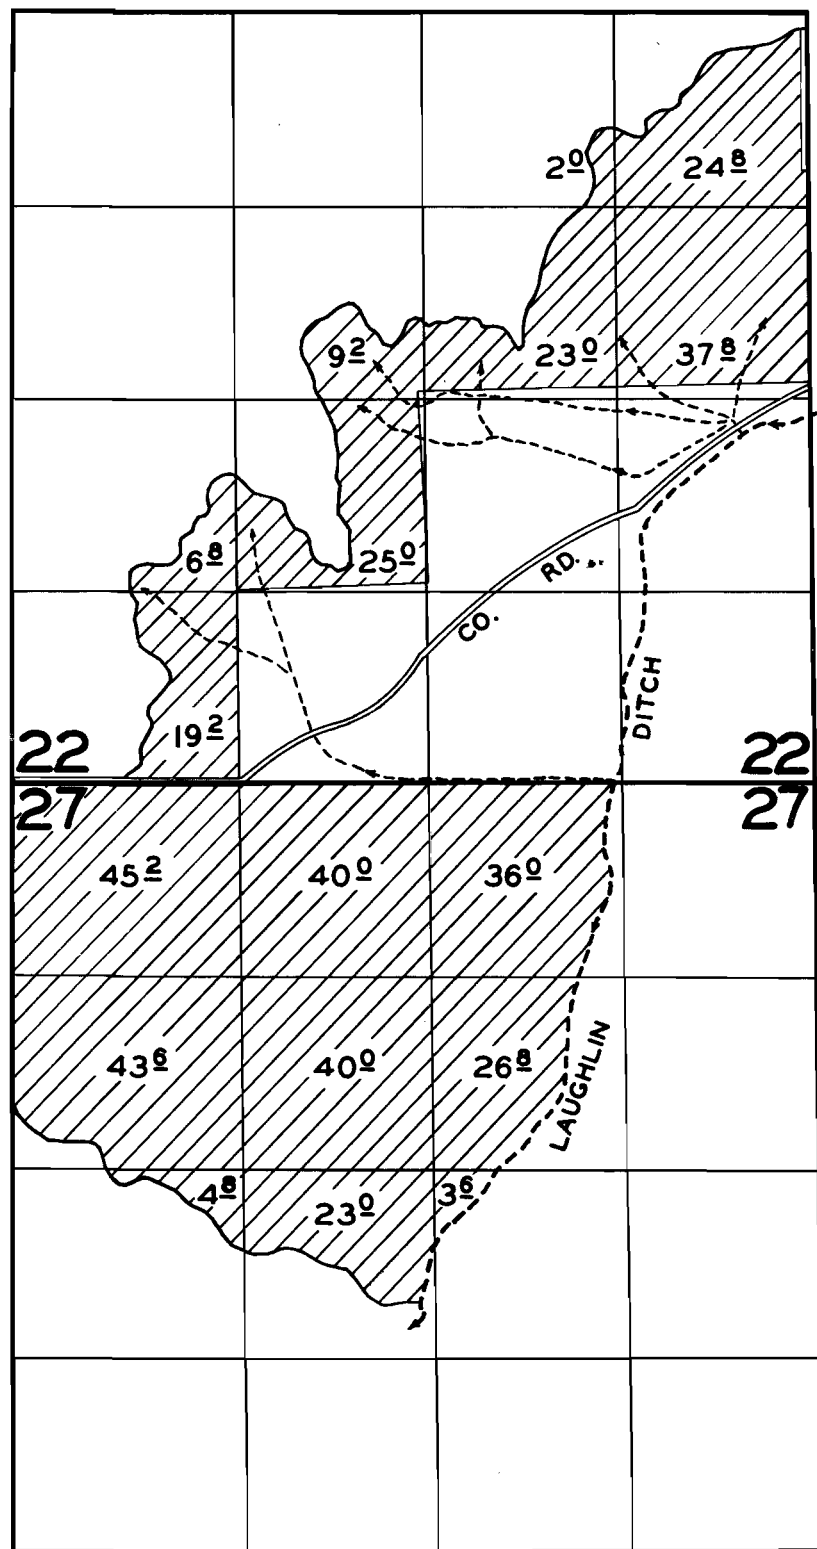

T. 16S. R. 25E. W.M.

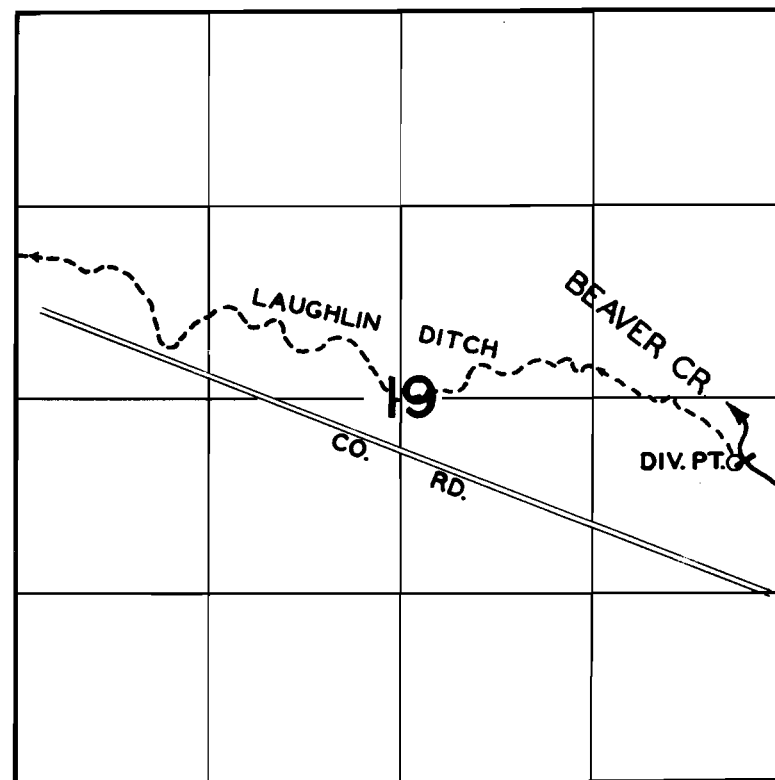

FINAL PROOF SURVEY
UNDER

APPLICATION NO. 22802 PERMIT NO. 17980
IN NAME OF

ROBERT T. LISTER

SURVEYED SEPT. 24 1957 BY *C. O. Burtch*