


T. 30S. R. 4W W.M.

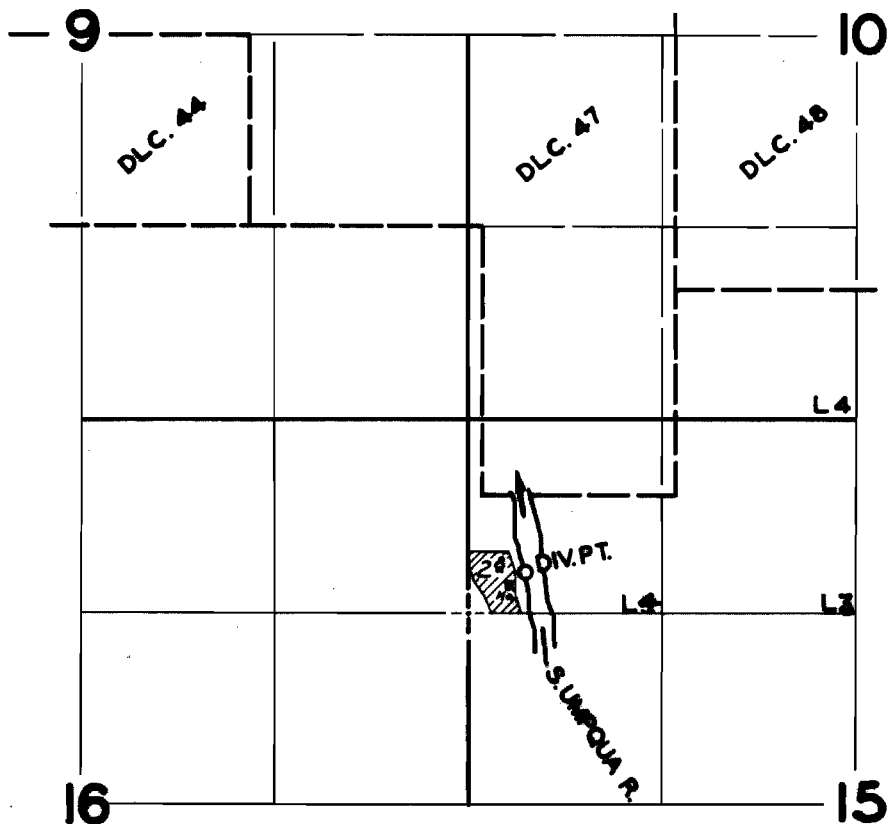

**FINAL PROOF SURVEY**

UNDER

Application No. 22874 Permit No. 17992

IN NAME OF

NORMAN J. & FRIEDA GREEN

Surveyed JUNE 24 1957, by C. O. Smith