


T. 8S. R. 4E. W.M.

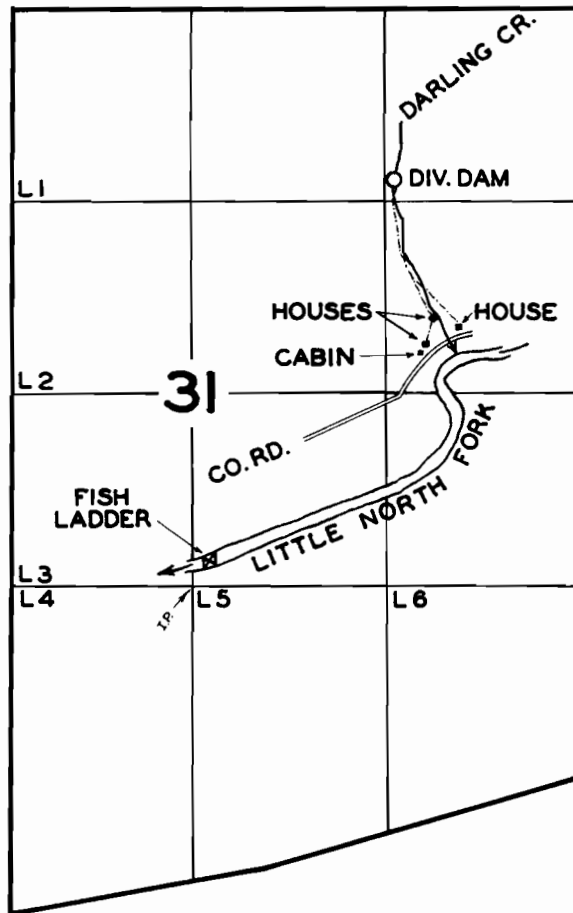

FINAL PROOF SURVEY
UNDER

Application No. 22734 Permit No. 18306
IN NAME OF

ELKHORN CORPORATION

Surveyed OCT. 4, 1957, by *m. Bishop*