


T.30 S. R. 4 W.W.M.

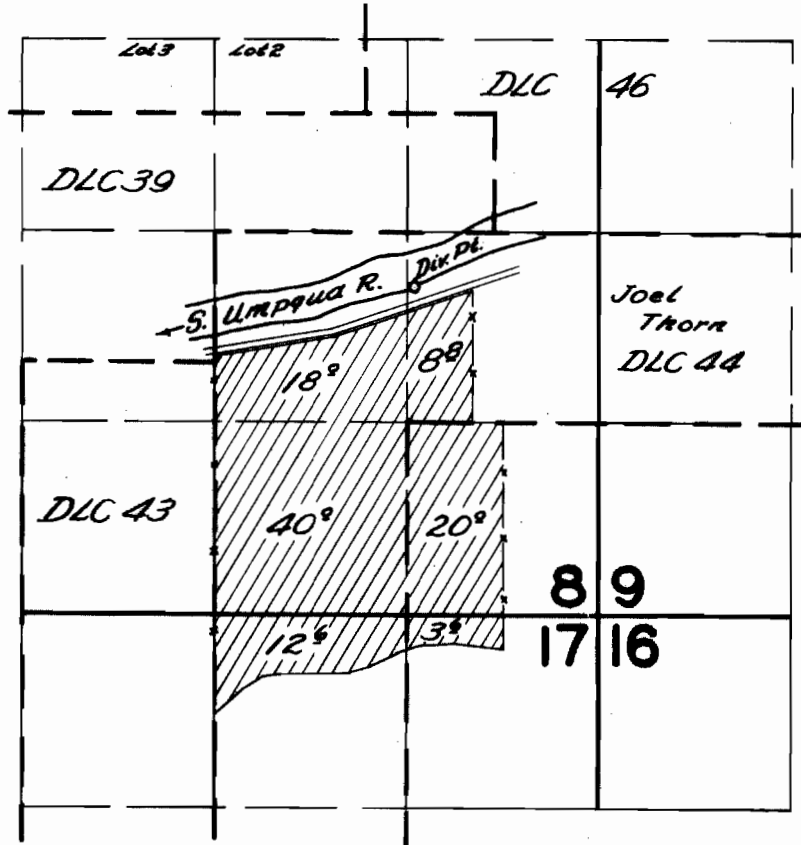

**FINAL PROOF SURVEY**  
UNDER

Application No. 23671 Permit No. 18664  
IN NAME OF

GEORGE NEUNER

Surveyed April 17, 1957, by C.O. Burtis