


T. 4 S. R. 1 W. W. M.

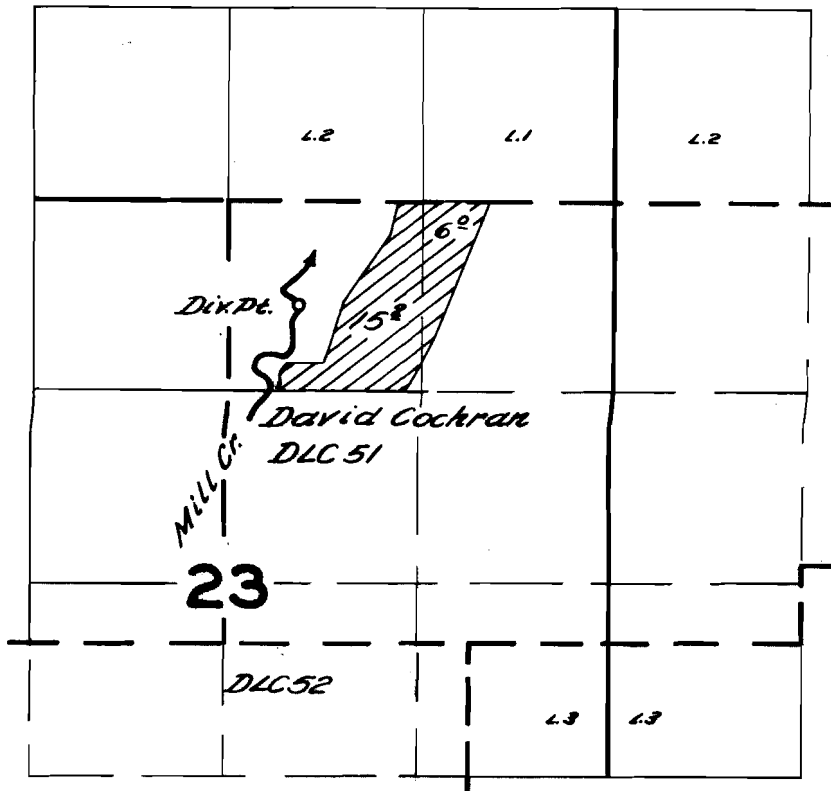

FINAL PROOF SURVEY
UNDER

Application No. 24114... Permit No. 19107...
IN NAME OF

..... *John C. & Lucille V. Harms*

Surveyed *Mar. 18, 1957*, by *C. D. Burtala*.....