


T.12 S.R.I W.W.M.

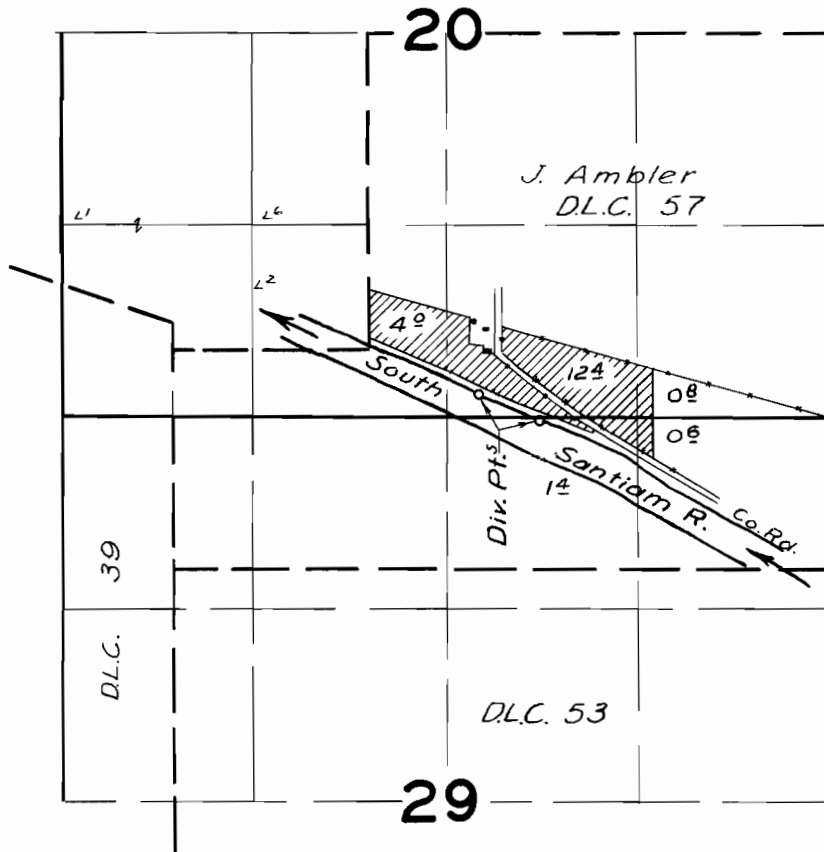

FINAL PROOF SURVEY UNDER

Application No. 24597 Permit No. 19379...
IN NAME OF

Carl A. Plagmann

Surveyed Oct. 3, 1957, by *Tm. Bish*