


T. 55. R. 11E. W.M.

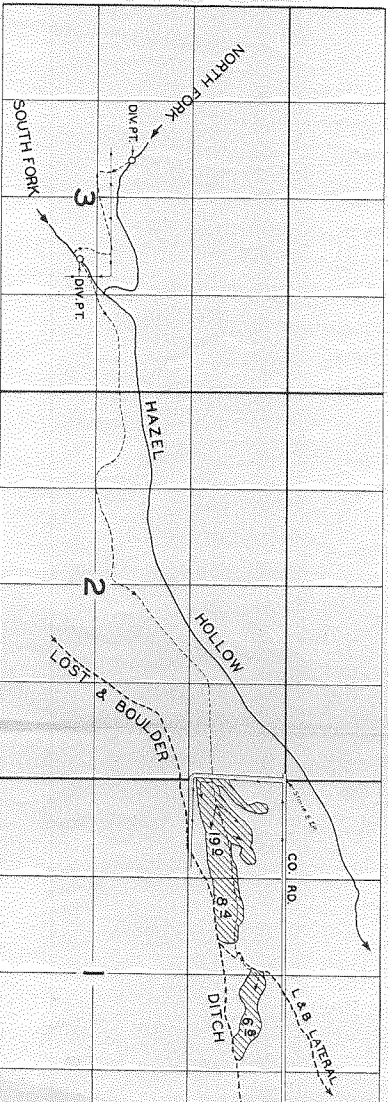

FINAL PROOF SURVEY

UNDER

Application No. 24907 Permit No. 19687

IN NAME OF

J. E. KENNEDY

Surveyed OCT. 17, 1957, by *Tom B. Bell*