


T.9 S.R.1 E.W.M.

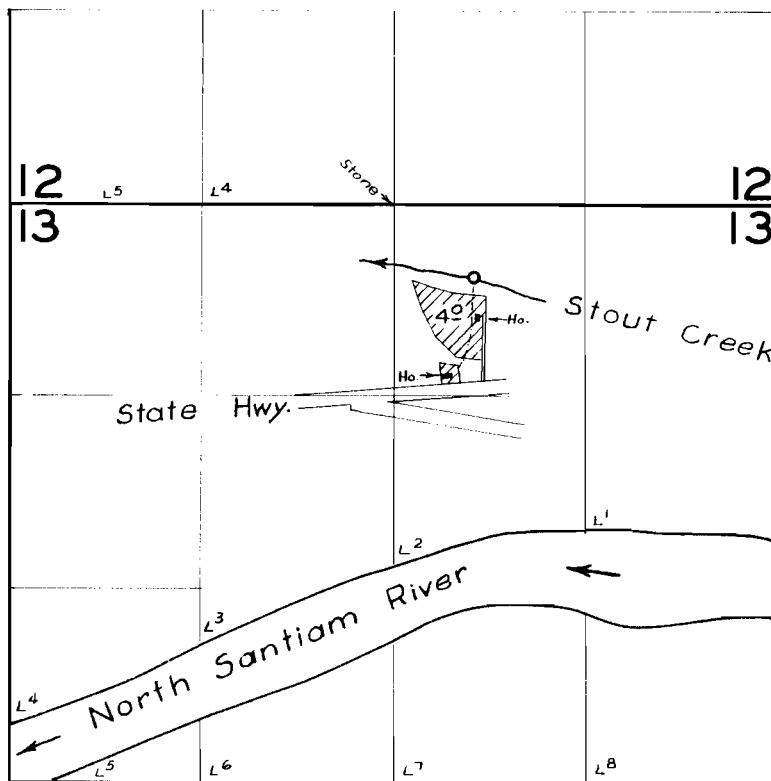

FINAL PROOF SURVEY
UNDER

Application No. 24800 Permit No. 19929
IN NAME OF

Lewis M. Russell

Surveyed Aug. 29 1957, by M. Bieh