


T.10 S.R.1 W.W.M.

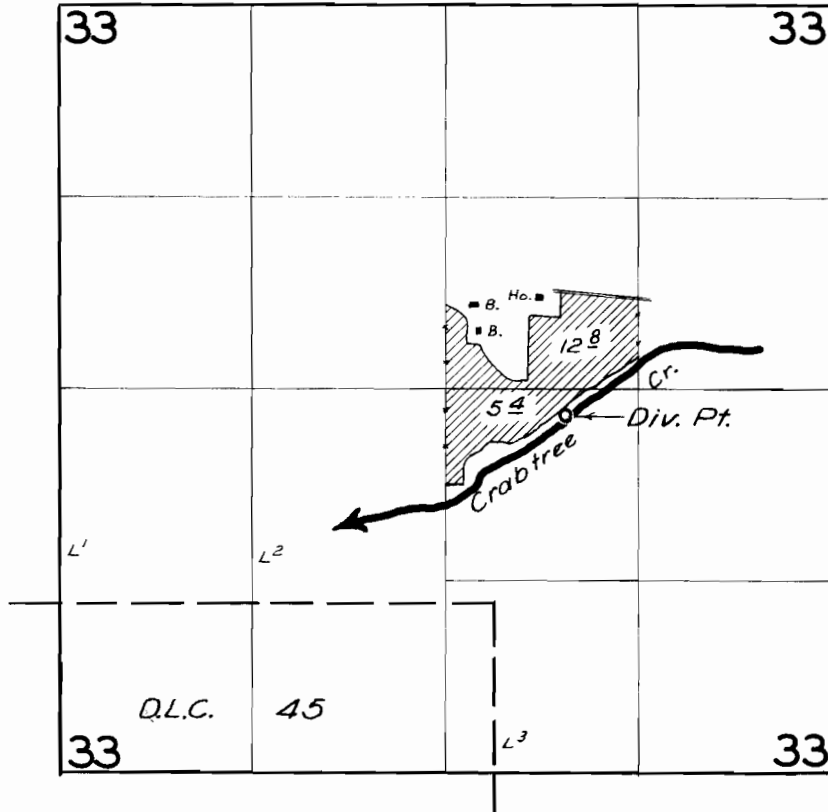

FINAL PROOF SURVEY UNDER

Application No. 24979 Permit No. 19942
IN NAME OF

Joseph Alves

Surveyed June 5 1957, by *M. Bisher*