


T.22 S.R.6 W.W.M.

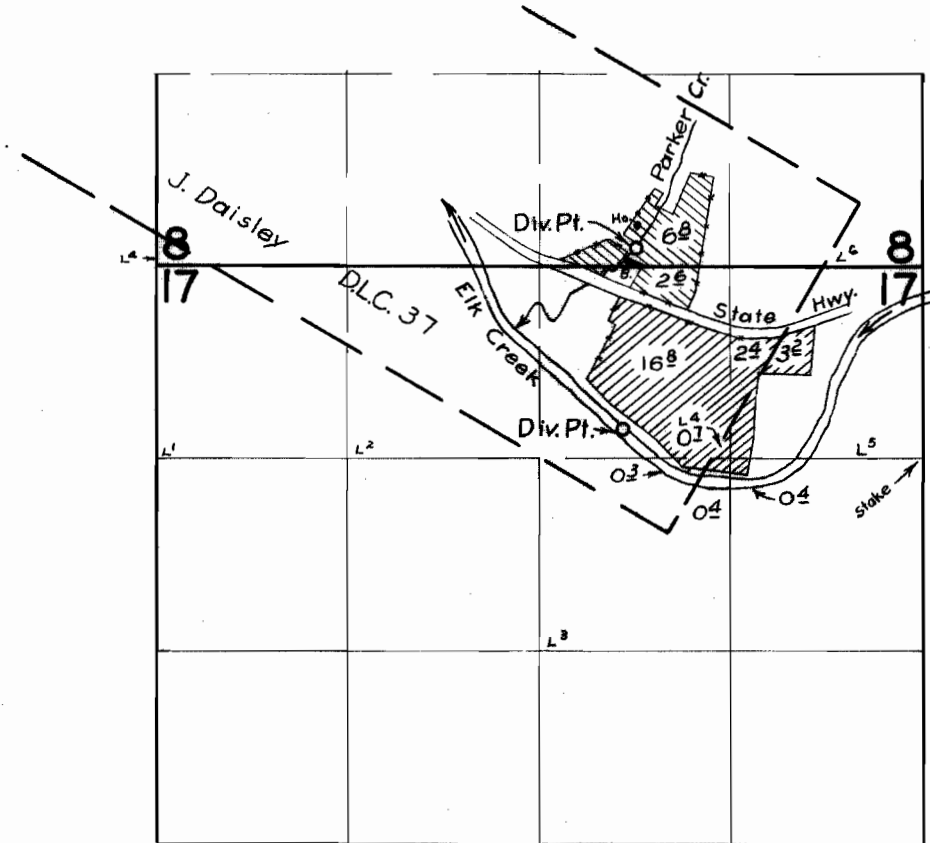

FINAL PROOF SURVEY UNDER

Application No. 25637 Permit No. 20109

IN NAME OF

Melvin Short

Surveyed Sept. 8 1957, by M. Bish