


T.7S.R.5&6W.W.M.

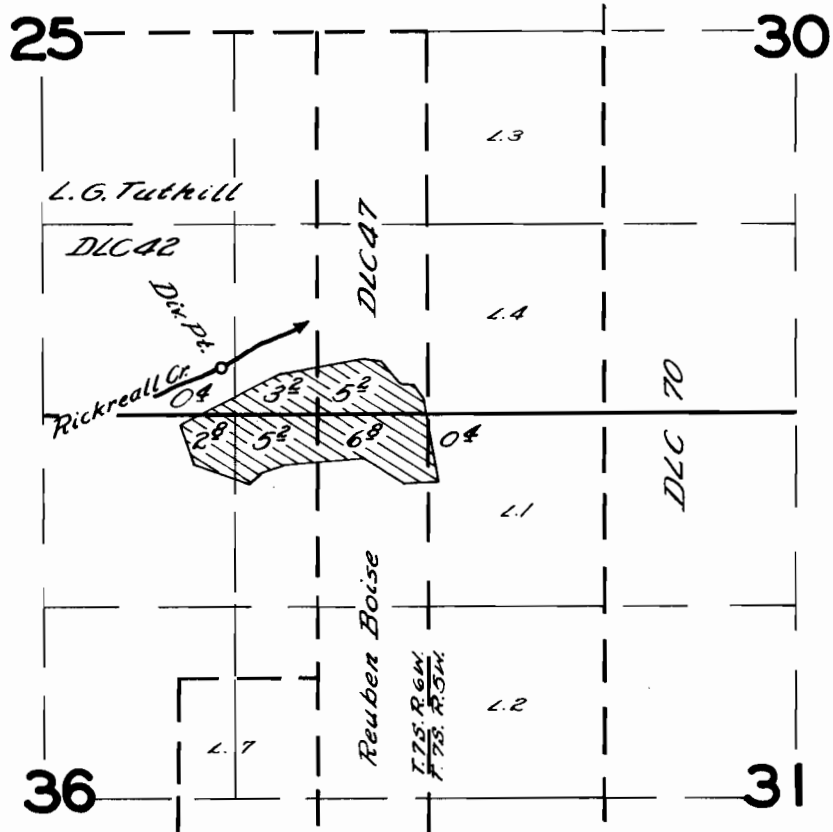

FINAL PROOF SURVEY UNDER

Application No. 25667... Permit No. 20126
IN NAME OF

Virgil Trick

Surveyed *Sept. 20 1957* by *C.O. Smith*