


T.3S.R.2E.W.M.

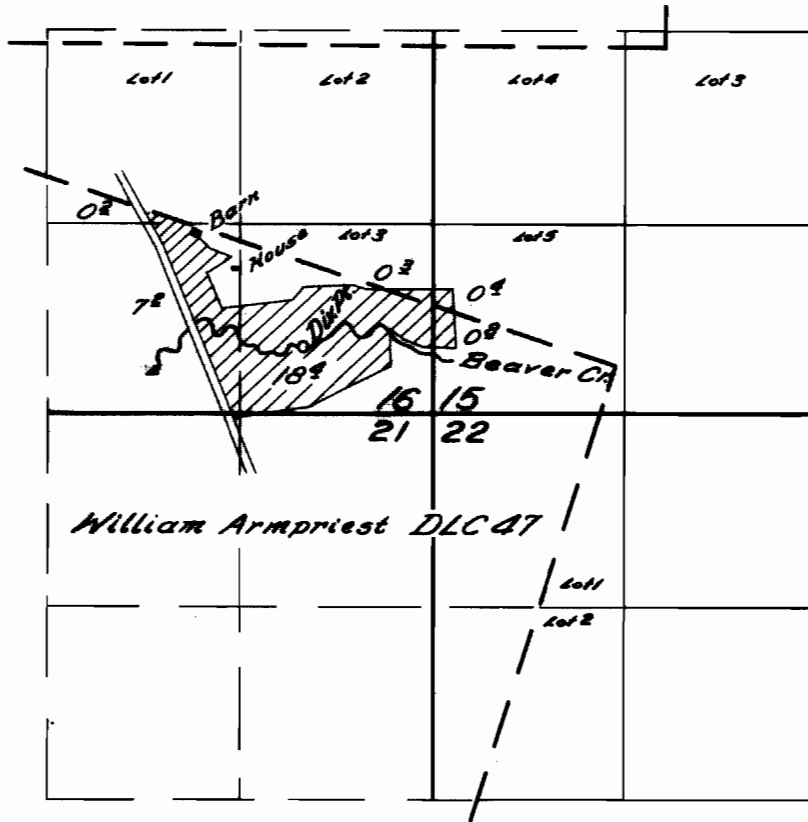

FINAL PROOF SURVEY
UNDER

Application No. 24575. Permit No. 20193.
IN NAME OF

Harold E. Bernier

Surveyed June 27, 1956, by *M. Bish*