


T18&19SRIEWM

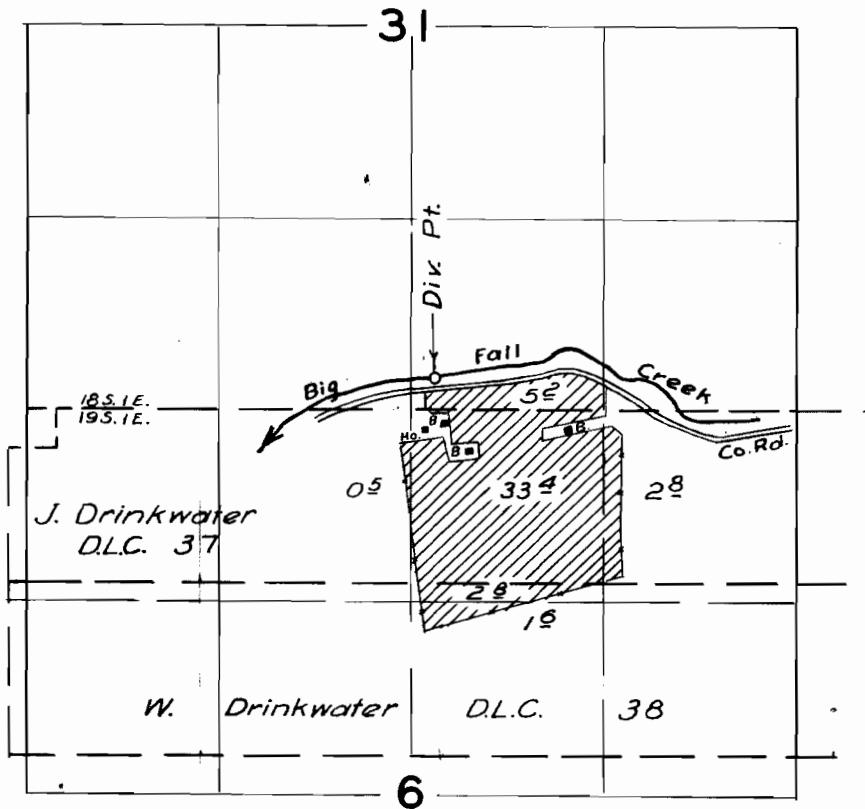

FINAL PROOF SURVEY UNDER

Application No. 25715 Permit No. 20254
IN NAME OF

James R. & Betty Wiemer

Surveyed June 18 1957, by Tom O'Shea