


T. 32 S. R. 6 E. W.M.

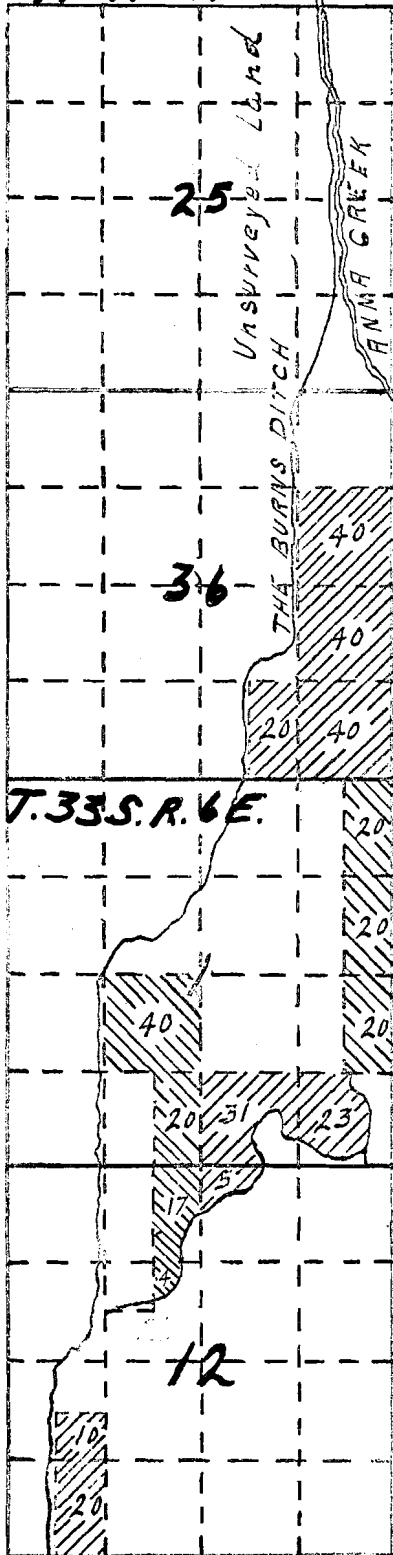

RECORDED
 NOV 4 1911
 SALEM, OREGON

Application No. 3734
 Permit No. 2474

Scale 2 in = 1 mi

Anna Ck.: misc.