


T.30 S.R.5-6W.W.M.

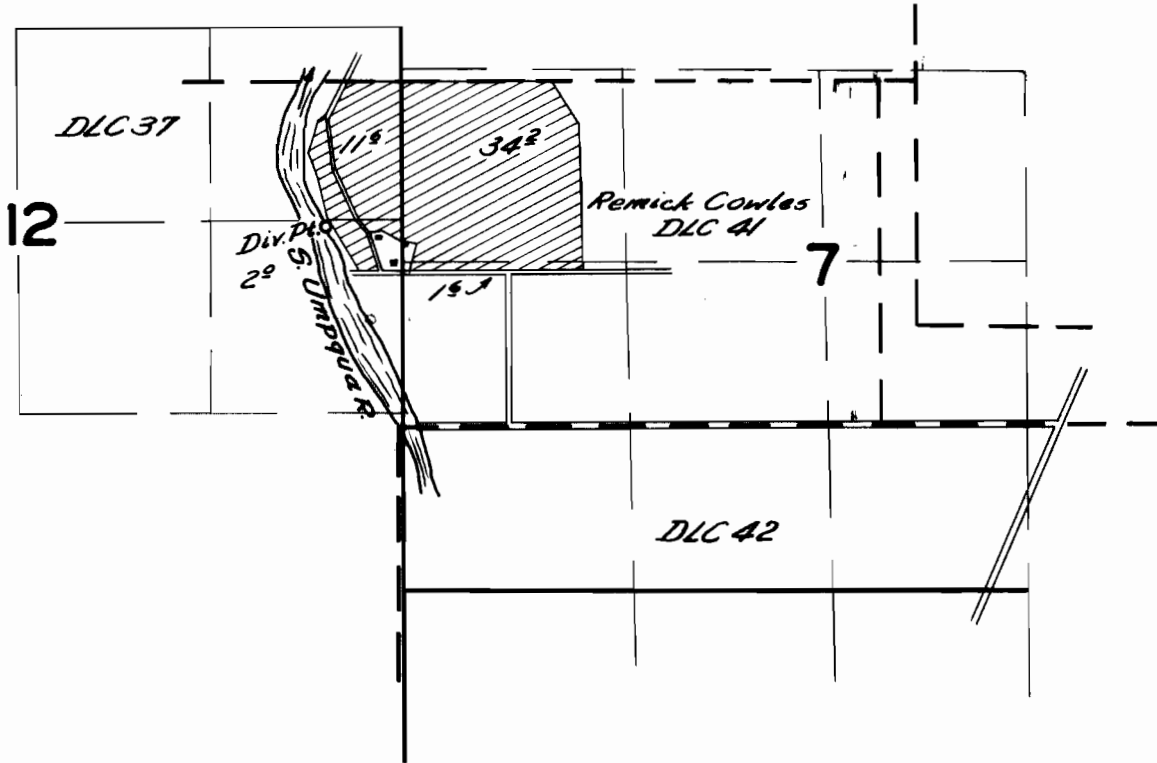

*Note: Section & DLC Lines are
located from Douglas County Records*

FINAL PROOF SURVEY

UNDER

Application No. 26202 Permit No. 20436

IN NAME OF

F.L. Matthews

Surveyed Oct. 16, 1956, by R.H. Whitby