


T.24 S.R.5 W.W.M.

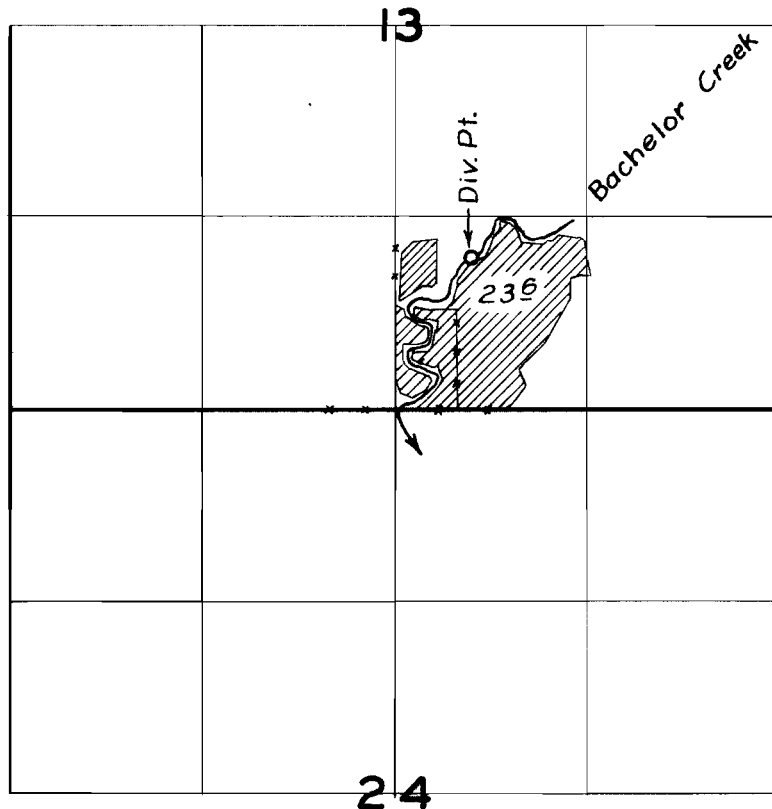

FINAL PROOF SURVEY
UNDER

Application No. 26127 Permit No. 20583
IN NAME OF

Mildred Kanipe

Surveyed Sept. 6 1957, by m. Bish