T.25 S.R.4 W.W.M.

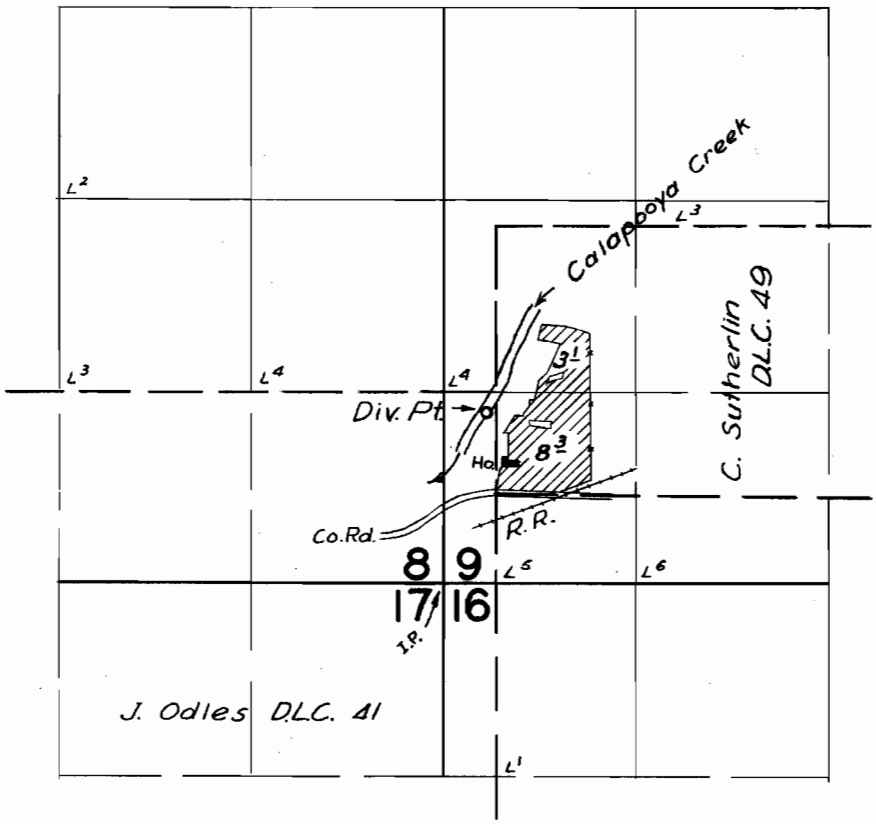

FINAL PROOF SURVEY

UNDER

Application No. 26437 Permit No. 20731

IN NAME OF

Burdette Harvey

Surveyed Aug. 21 1956, by C.O. Bartels

1956-C & 1957-C

N.B.