


T.23S.R.4 W.W.M.

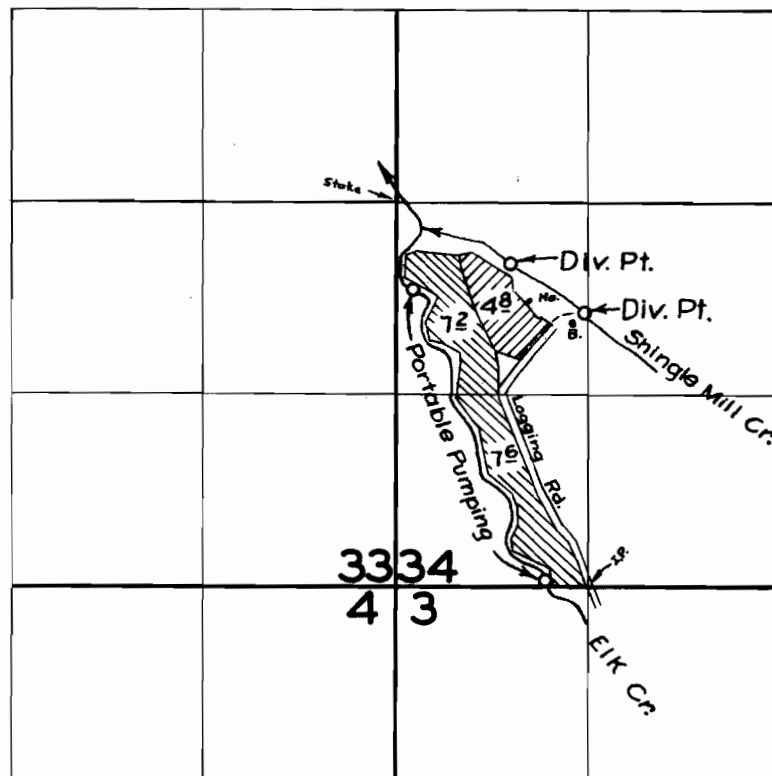

FINAL PROOF SURVEY
UNDER

Application No. 26782 Permit No. 21041
IN NAME OF

Laurel James

Surveyed Sept. 7 1957, by M. Bish