


T.25S.R.6W.W.M.

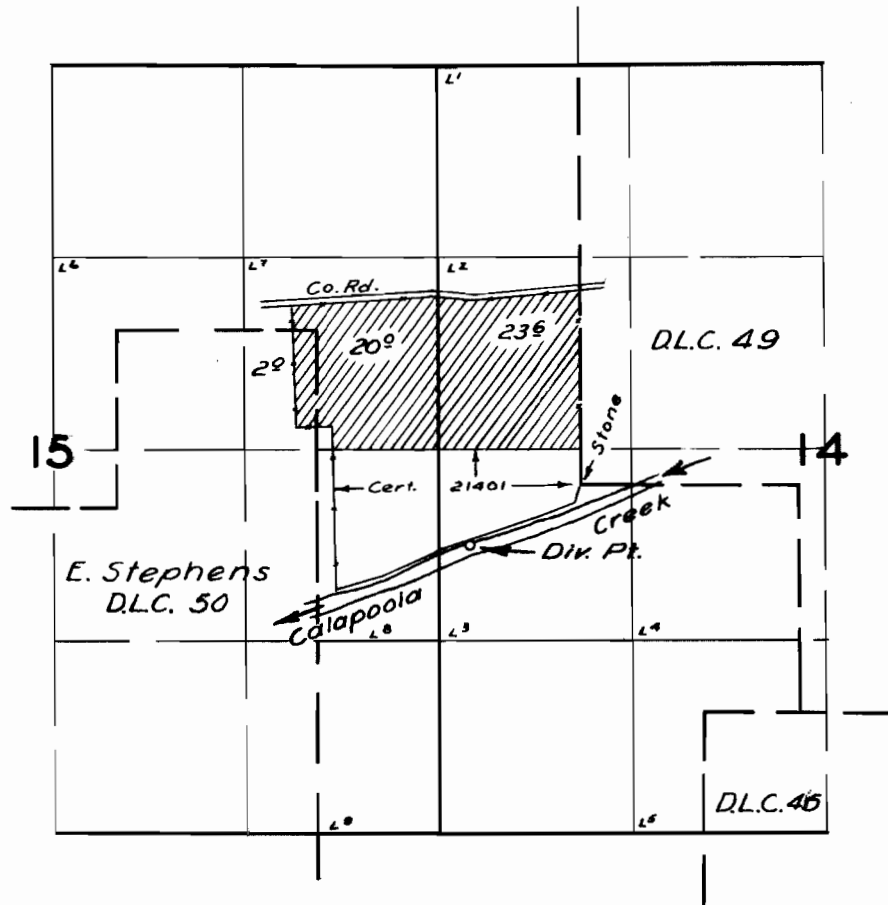

FINAL PROOF SURVEY UNDER

Application No. 26818 Permit No. 21060
IN NAME OF

George M. Wilcox & Son

Surveyed Aug. 16, 1957, by m. Bish