


T.6S.R.3W.W.M.

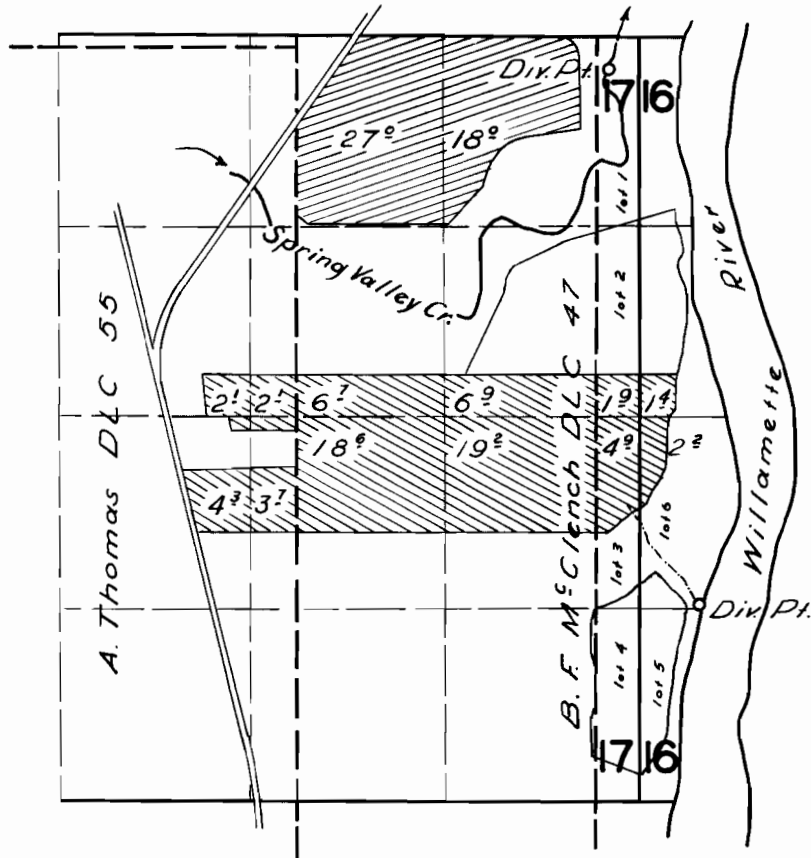

FINAL PROOF SURVEY UNDER

Application No. 27065 21295
 29870 Permit No. 23578



IN NAME OF

FRANK B. WINDSOR

Surveyed Nov. 2, 1956, by *M. Bish*