T.6S.R.3W.W.M.

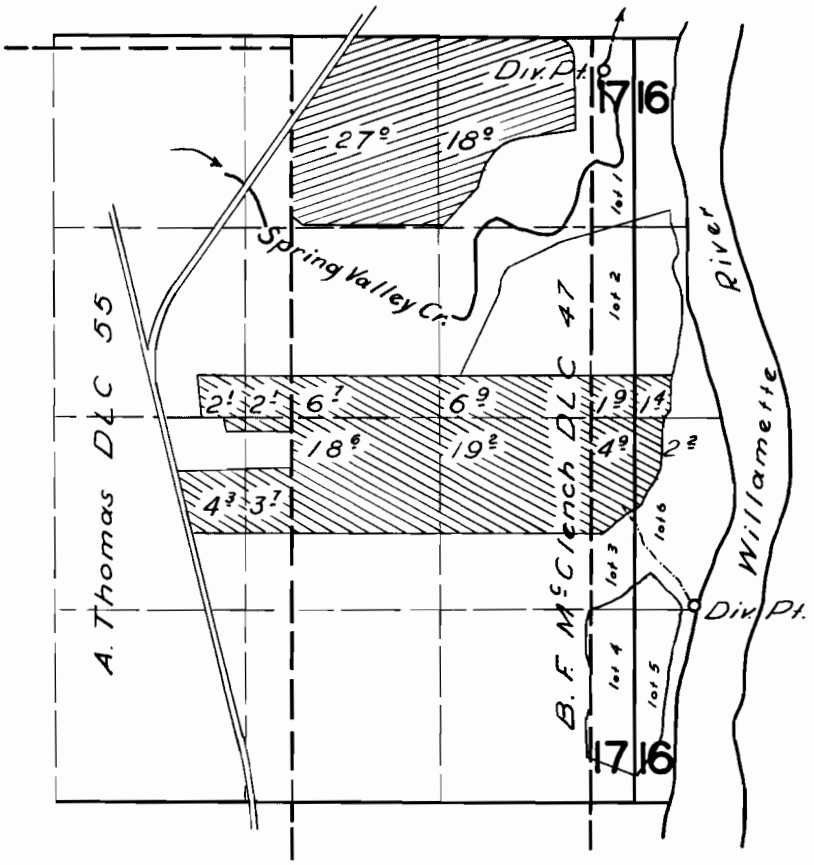

FINAL PROOF SURVEY

UNDER

Application No. 27065 / 29870 Permit No. 21295 / 23578

IN NAME OF

FRANK B. WINDSOR

Surveyed Nov. 2 1956, by Tm. Bish

DFP-2D-21

RHW