


T27SR4WWM

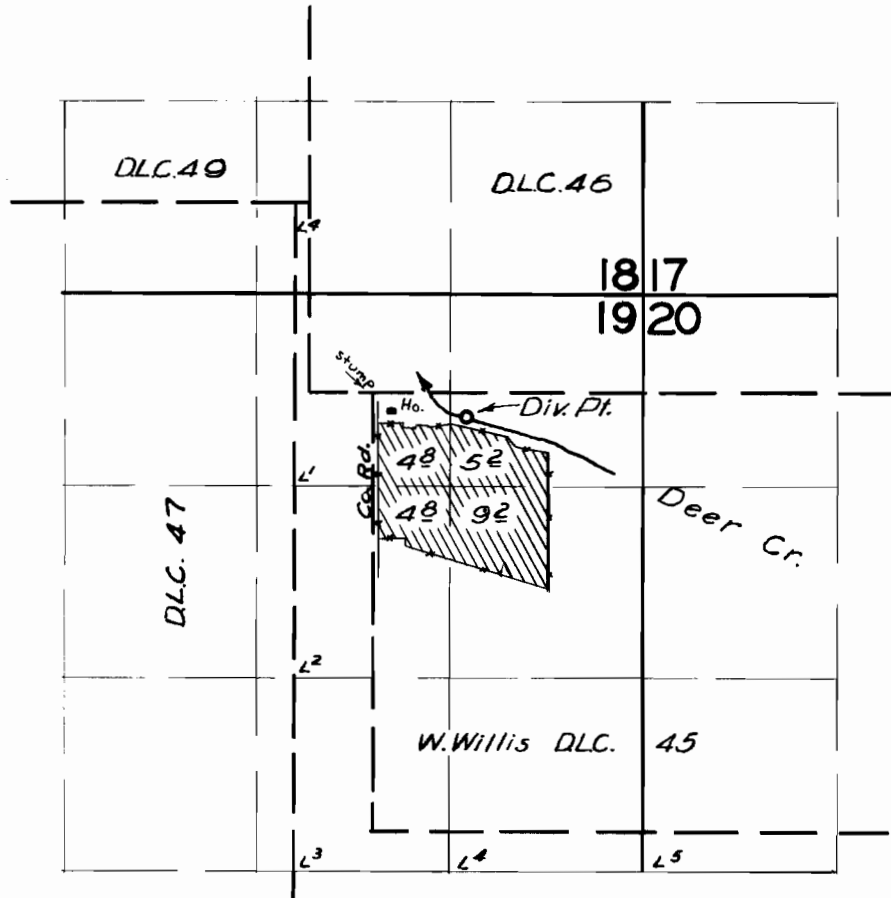

FINAL PROOF SURVEY

UNDER

Application No. 27242 Permit No. 21435

IN NAME OF

Bert J. Gilbert

Surveyed July 17 1957, by m. Bish