


T.20S.R.3W.W.M.

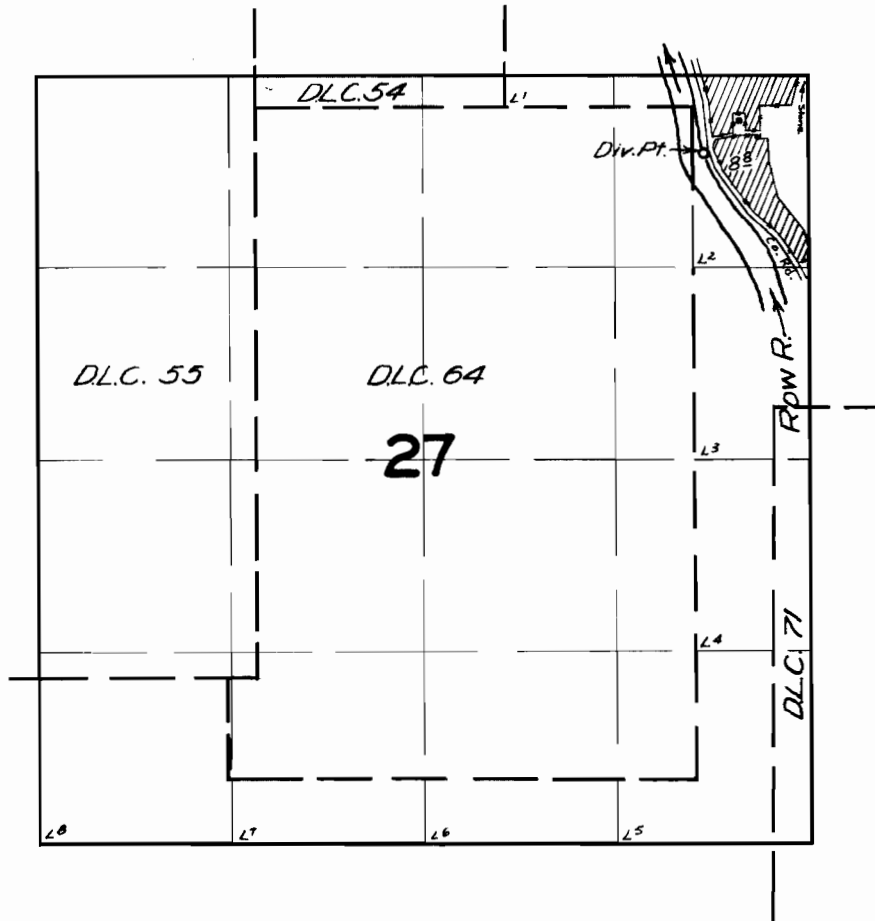

FINAL PROOF SURVEY UNDER

Application No. 27245 Permit No. 21438
IN NAME OF

Maurice W. & Ethel Fine

Surveyed April 16 1957, by M. Bick