


T.5S.R.1W.W.M.

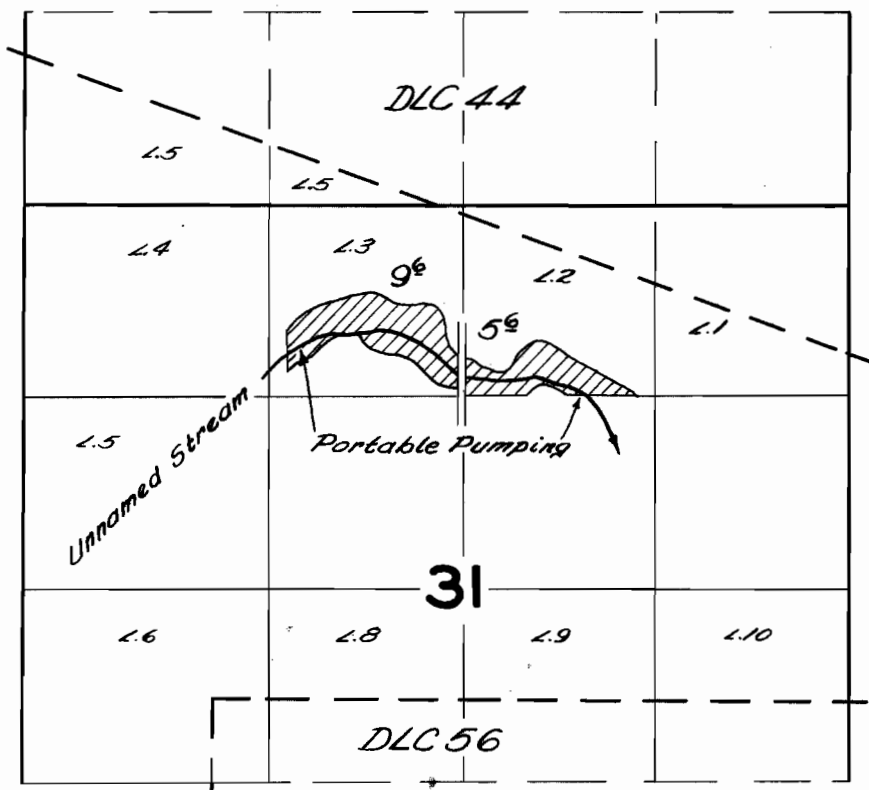

FINAL PROOF SURVEY UNDER

Application No. 21354 Permit No. 21536
IN NAME OF

Anna McGuire

Surveyed Sept. 5 1957, by C.O. Barth