


T.13S.R.5W.W.M.

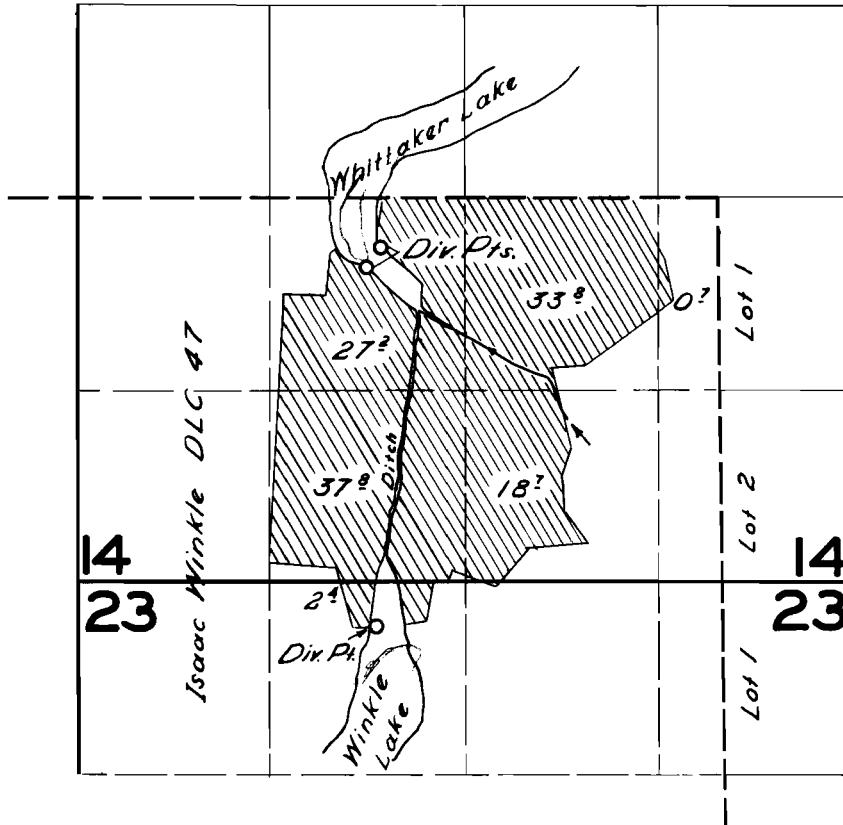

FINAL PROOF SURVEY

UNDER

Application No. 27392 Permit No. 21557

IN NAME OF

J. RICHARD GUERBER

Surveyed 25 Apr. 1957, by [Signature]