


T.12 S.R.27 E.W.M.

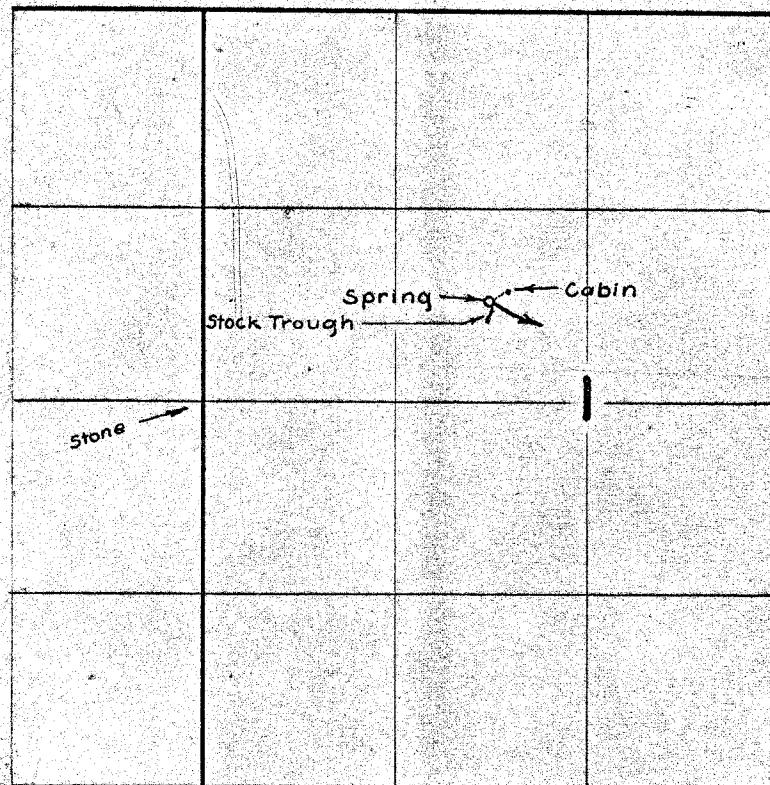

FINAL PROOF SURVEY
UNDER

Application No. 27522... Permit No. 21682...
IN NAME OF

George MacKay

Surveyed 21 Sept. 1957, by M. Bish