


T. 3N. R. 27E. W.M.

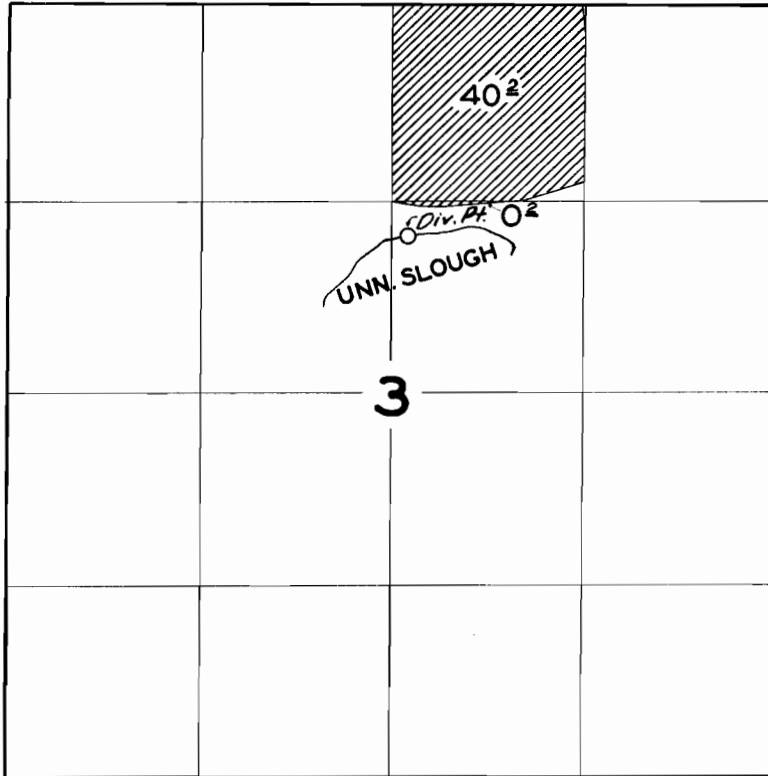

FINAL PROOF SURVEY

UNDER

Application No. 28278 . Permit No. 22234

IN NAME OF

FEDERATED LIVESTOCK CORP.

Surveyed MAY 31 1957, by C.O. Bastels