


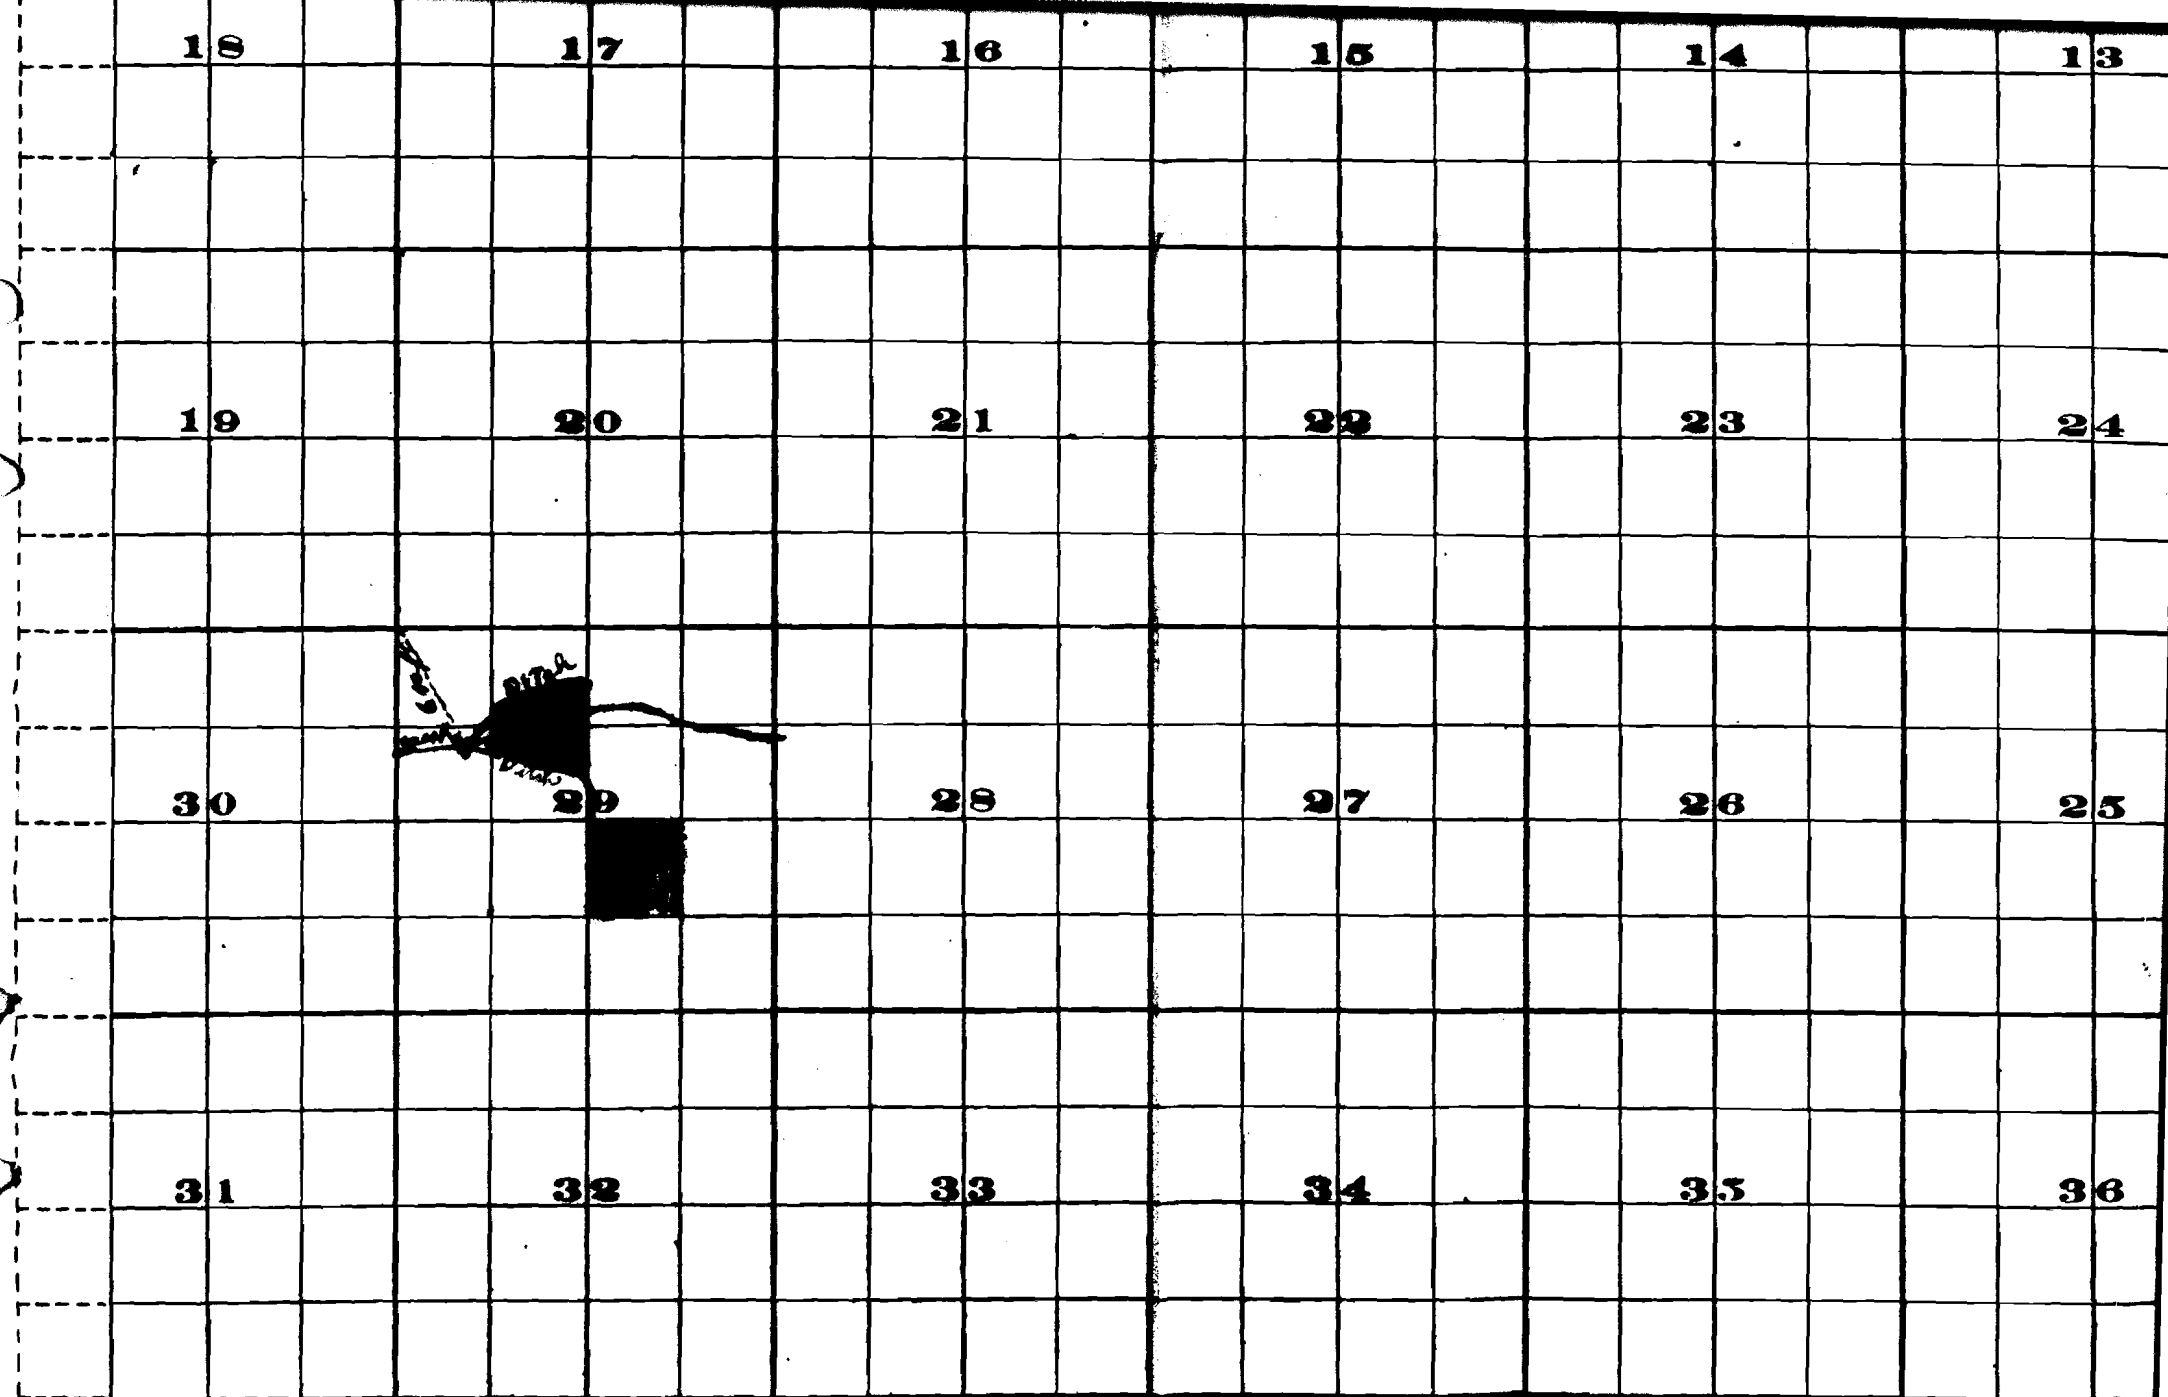

FROM OFFICE OF THE STATE ENGINEER, SALEM

T20S R22E

Application No. 4353

Permit No. 2617