


T. 6N. R. 36E. W.M.

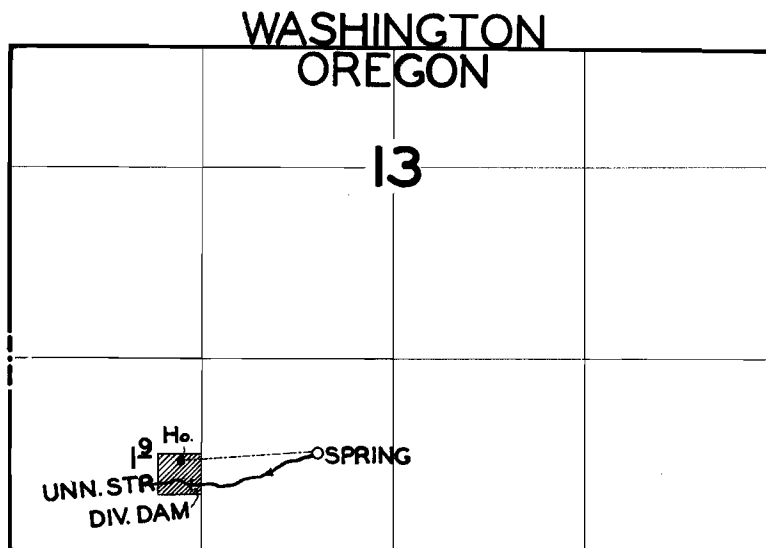

FINAL PROOF SURVEY

UNDER

Application No. 31661 24944-IRRIGATION  
28419 Permit No. 22273-DOMESTIC  
IN NAME OF

HARRY W. & GERTRUDE HOUCHIN

NOV. 29  
Surveyed JUNE 5 1957, by *C. C. Smith*