


T. 6N. R. 36E. W.M.

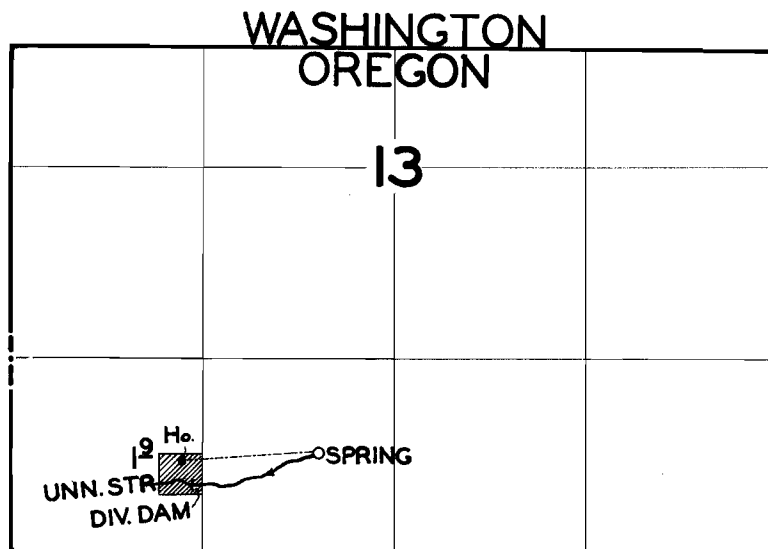

FINAL PROOF SURVEY

UNDER

Application No. 31661 28419 Permit No. 24944-IRRIGATION 22273-DOMESTIC
IN NAME OF

HARRY W. & GERTRUDE HOUCHIN

NOV. 29
Surveyed JUNE 5 1957, by *C.O. Bartels*