


T. 5N. R. 35E. W.M.

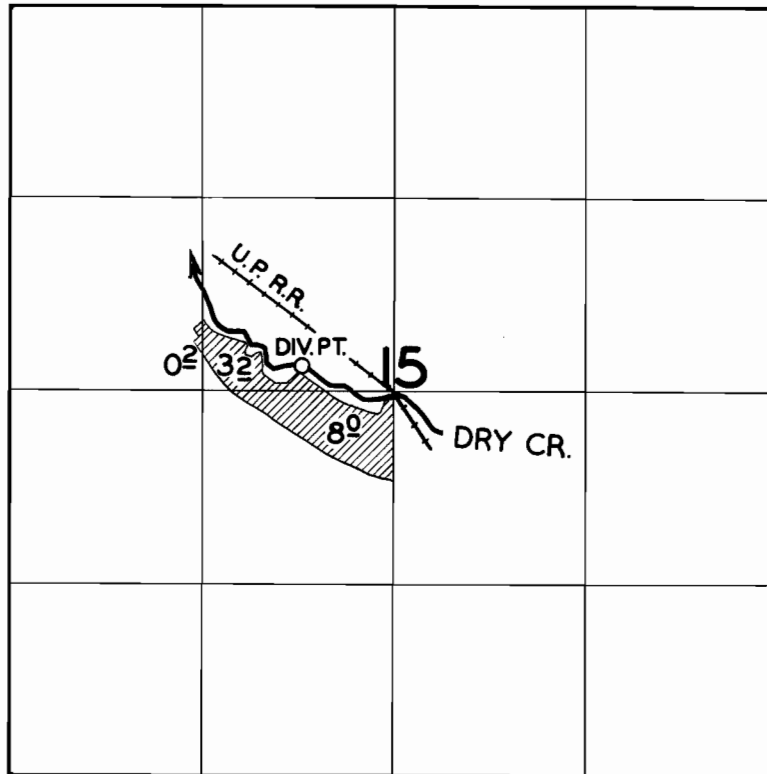

FINAL PROOF SURVEY

UNDER

Application No. 28380 Permit No. 22390

IN NAME OF

R. R. GRAY

Surveyed JUNE 3 1957, by *C. O. Bartlett*