


T.14S.R.6W.W.M.

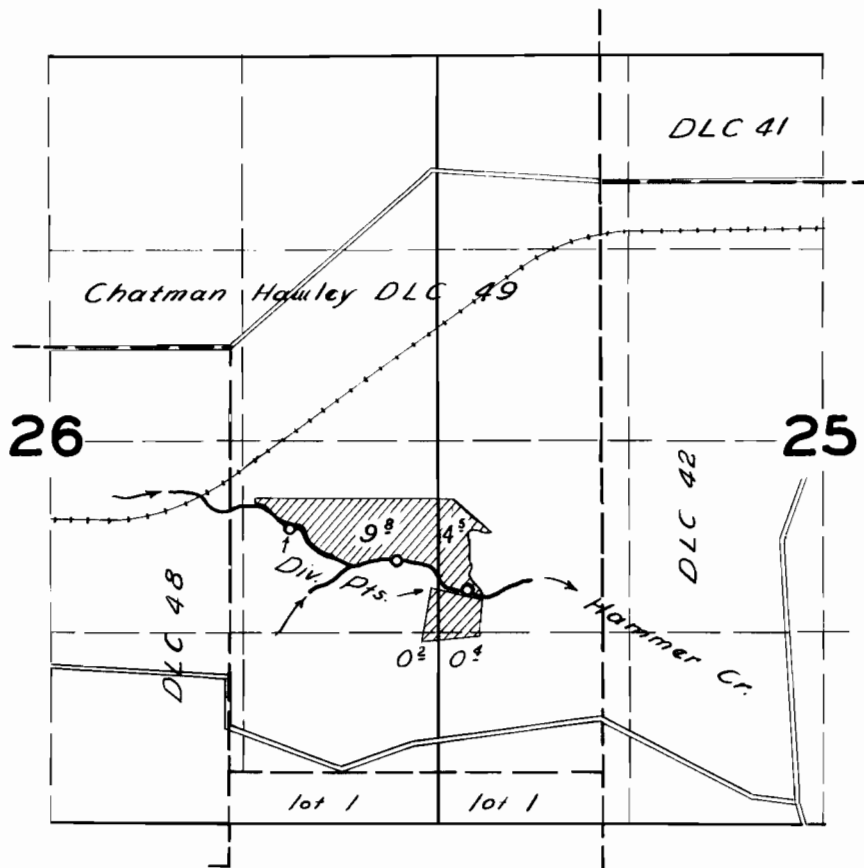

FINAL PROOF SURVEY UNDER

Application No 28641 Permit No. 22551
IN NAME OF

CECIL E. WILLET

Surveyed 22 Apr 1957, by *R. H. Kelly*