


T.6S.R.IW.W.M.

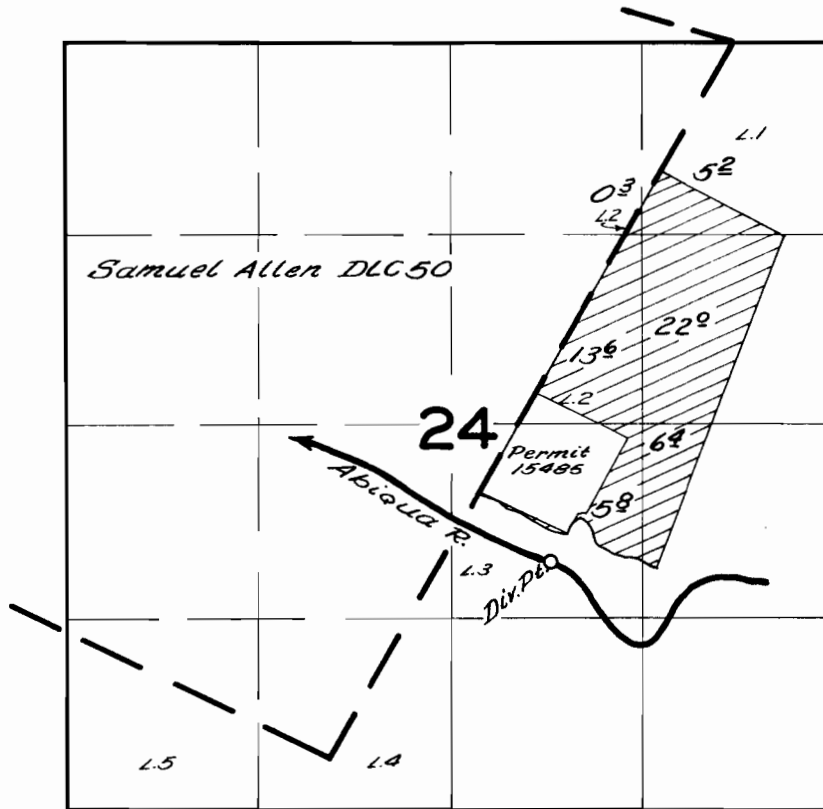

FINAL PROOF SURVEY
UNDER

Application No. 29061 Permit No. 22857
IN NAME OF

Albert C. Schindler

Surveyed Mar. 19 1957, by *C.D. Banteb*