


T.6S.R.1E.W.M.

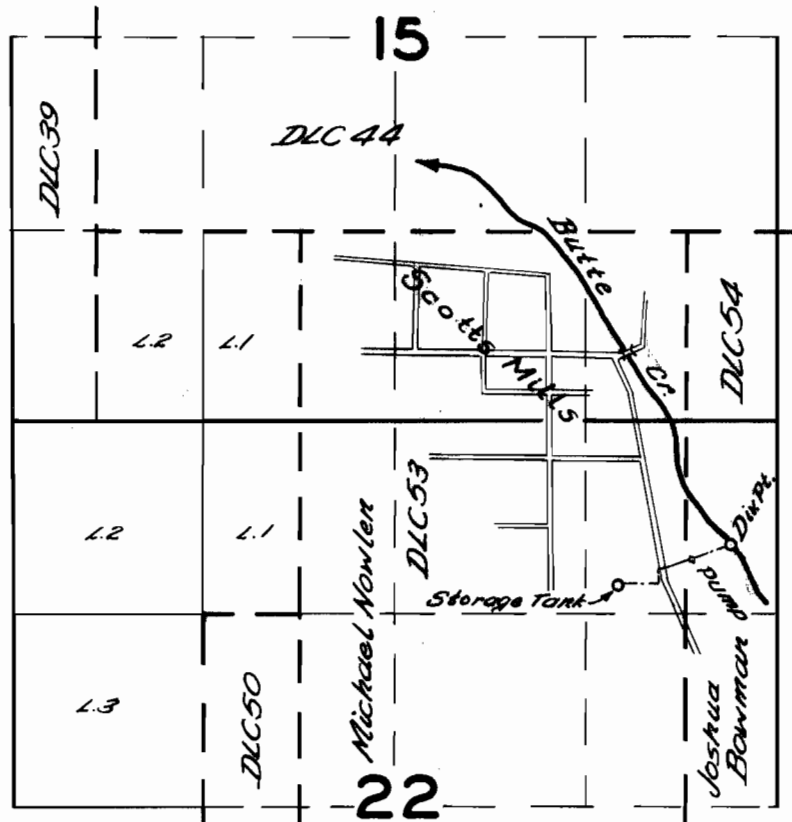

FINAL PROOF SURVEY
UNDER

Application No. 29284 Permit No. 23023
IN NAME OF

CITY OF SCOTTS MILLS

Surveyed May 24 1957 by C.O. Bartlett