


T. 14S. R. 15E. W.M.

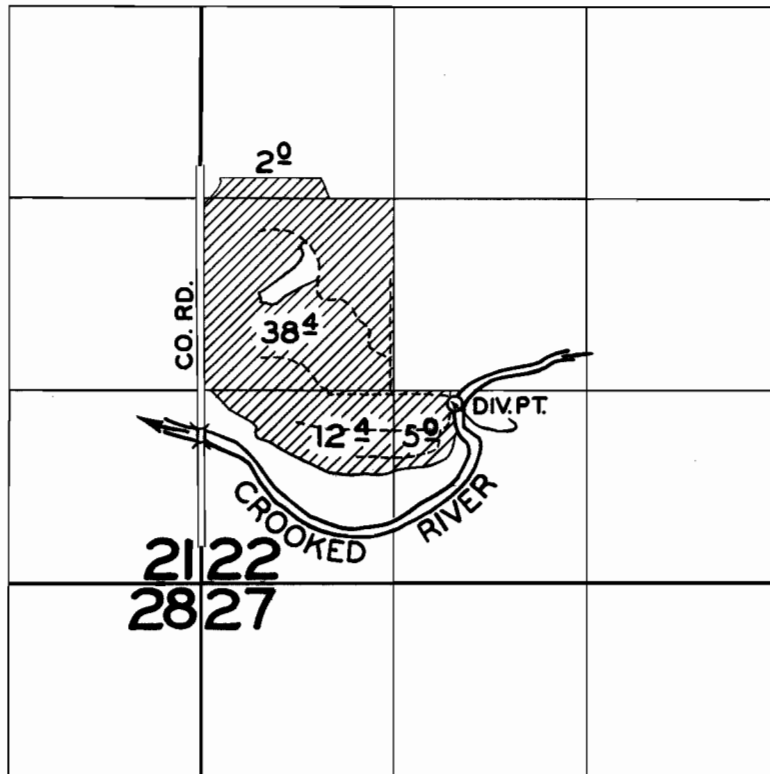

FINAL PROOF SURVEY
UNDER

Application No. 29298 Permit No. 23081
IN NAME OF

WILLARD L. POWELL

Surveyed JULY 30, 1957. by C. O. Smith